


STATE OF KANSAS
STATE CORPORATION COMMISSION

WELL PLUGGING RECORD

Give All Information Completely
Make Required Affidavit
Mail or Deliver Report to:
Conservation Division
State Corporation Commission
211 No. Broadway
Wichita, Kansas

NORTH

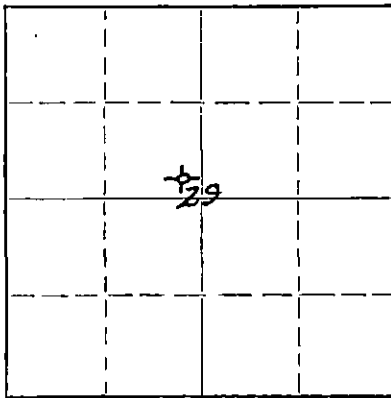

Locate well correctly on above
Section Plat

Pawnee

County. Sec. 29 Twp 22S Rge. 15 (XXX) (W)

Location as "NE/CNW/SW" or footage from lines SE SE NW

Lease Owner D. R. Lauck Oil Company, Inc.

Lease Name Miller "C"

Well No. 1

Office Address 301 So. Broadway Wichita, 2 Kans

Character of Well (completed as Oil, Gas or Dry Hole) dry hole

Date well completed December 27 19 57

Application for plugging filed " " 19 57

Application for plugging approved " " 19 57

Plugging commenced " " 19 57

Plugging completed " " 19 57

Reason for abandonment of well or producing formation

dry hole

If a producing well is abandoned, date of last production 19

Was permission obtained from the Conservation Division or its agents before plugging was commenced? Yes

Name of Conservation Agent who supervised plugging of this well Frank Broadfeet

Producing formation Depth to top Bottom Total Depth of Well 4045 Feet

Show depth and thickness of all water, oil and gas formations.

OIL, GAS OR WATER RECORDS

CASING RECORD

FORMATION	CONTENT	FROM	TO	SIZE	PUT IN	PULLED OUT
		0	247	8 5/8"	247'	none

Describe in detail the manner in which the well was plugged, indicating where the mud fluid was placed and the method or methods used in introducing it into the hole. If cement or other plugs were used, state the character of same and depth placed, from feet to feet for each plug set.

hole filled with mud 4045 - 160
plug 160 - 156
cement 156 - 6 bottom of cellar

FILED
JAN 7 1958
1-7-58
CONSERVATION DIVISION
Wichita, Kansas

(If additional description is necessary, use BACK of this sheet)

Name of Plugging Contractor Sun Cementing Company

Address Great Bend Kansas

STATE OF Kansas, COUNTY OF Sedgwick, ss.

John H. Knightley (employee of owner) or (owner or operator) of the above-described well, being first duly sworn on oath, says: That I have knowledge of the facts, statements, and matters herein contained and the log of the above-described well as filed and that the same are true and correct. So help me God.

(Signature)

Wichita, Kansas
(Address)

SUBSCRIBED AND SWORN to before me this 6th day of January 19 58

My commission expires Sept. 14, 1959

Notary Public.

PLUGGING
FILE SEC 29 T 22 R 15
BOOK PAGE 73 LINE 15

D. R. Lauck Oil Company, Inc.

Miller C #1

SE SE NW Sec. 29-22S-15W
Pawnee County Kansas

Commenced: December 14, 1957

Completed: December 27, 1957

Casing Record: 247' 8 5/8" cem. with 210 sacks

Elevation: GR 2004; DF 2006; KB 2008

Drillers LogTops

			Sample
Clay & sand	200	Anhydrite (Drillers)	965 + 1043
shale & shells	247	Heebner	3428 - 1420
blue shale	285	Brown Lime	3545 - 1537
Dakota Sand	335	Lansing Kansas City	3558 - 1550
shale & shells	370	Conglomerate	3865 - 1857
red bed	965	Viola	3882 - 1874
Anhydrite	995	Simpson shale	3971 - 1963
shale & shells	1250	Arbuckle	4022 - 2014
salt & shale	1350	Rotary Total Depth	4045 - 2037
shale & shells	1915		
lime	2250	DST #1 (W) 3979-4005	open 1 hr, strong
lime (broken)	2300		blow 1 hr. recovered 900'
shale & lime	3060		salt water; IFP zero, FFP 450#
broken Lime & shale	3265		BHP 1300# in 30 min.
shale & lime	3355		
lime	3403	DST #2 (W) 4023-4045	RTD, open 45 min.
shale & lime	3650		very strong blow at first
lime	3870		and steadily declined.
cherty conglomerate	3900		Dead in 28 min. recovered
Viola chert	3906		3000 ft sulphur water,
lime & chert	3941		IFP 1120#, FFP 1320#
lime	3975		BHP 1320# in 30 min.
lime & chert	3993		
sand	4005		
lime & shale	4022		D & A
lime	4045	RTD	

PLUGGING

FILE SEC. 29 T. 22 R. 15W
BOOK PAGE 73 LINE 15