

STATE OF KANSAS  
STATE CORPORATION COMMISSION

Form CP-4


All Information Completely  
Required Affidavit  
or Deliver Report to:  
Conservation Division  
State Corporation Commission  
211 No. Broadway  
Wichita, Kansas

WELL PLUGGING RECORD

Pawnee County, Sec. 29 Twp. 22S Rge.      (E) 15 (W)

Location as "NE/CNW%SW%" or footage from lines SW-NE-SE/4  
Lease Owner William H. Pine  
Lease Name Boling Well No. 1  
Office Address 4th Floor McCulloch Bldg., Okmulgee, Oklahoma  
Character of Well (completed as Oil, Gas or Dry Hole) Dry Hole  
Date well completed September 3 19 63  
Application for plugging filed September 3 19 63  
Application for plugging approved September 3 19 63  
Plugging commenced September 3 19 63  
Plugging completed September 3 19 63  
Reason for abandonment of well or producing formation Dry Hole

NORTH

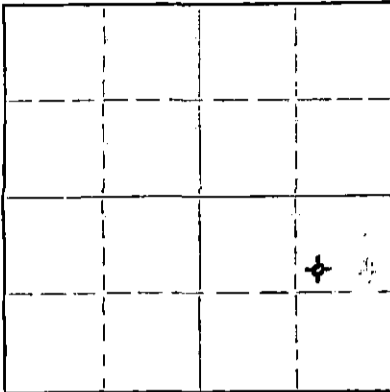

Locate well correctly on above  
Section Plat

If a producing well is abandoned, date of last production      19       
Was permission obtained from the Conservation Division or its agents before plugging was com-  
menced? Yes

Name of Conservation Agent who supervised plugging of this well Eldon Petty, Hays, Kansas  
Producing formation      Depth to top      Bottom      Total Depth of Well 4020 Feet  
Show depth and thickness of all water, oil and gas formations.

OIL, GAS OR WATER RECORDS

CASING RECORD

| FORMATION | CONTENT | FROM | TO   | SIZE | PUT IN | PULLED OUT |
|-----------|---------|------|------|------|--------|------------|
|           | 8-5/8"  | 1    | 235' |      |        |            |
|           |         |      |      |      |        |            |
|           |         |      |      |      |        |            |
Describe in detail the manner in which the well was plugged, indicating where the mud fluid was placed and the method or methods used in introducing it into the hole. If cement or other plugs were used, state the character of same and depth placed, from      feet to      feet for each plug set.

Hole plugged as follows: Plugged at 230' with 30 sacks of cement and 1/4 sack of hulls and mud to 40'; plugged with 10 sacks of cement and 1/4 sack of hulls. Job completed at 10:30 A. M. September 3, 1963.

RECEIVED  
STATE CORPORATION COMMISSION

SEP 13 1963

CONSERVATION DIVISION  
Wichita, Kansas

9-13-63

(If additional description is necessary, use BACK of this sheet)

Name of Plugging Contractor Strata Drilling, Inc.  
Address P. O. Box 355, Great Bend, Kansas

STATE OF KANSAS, COUNTY OF BARTON, ss.  
Ralph Schuyler (employee of owner) or (~~owner or operator~~) of the above-described well, being first duly sworn on oath, says: That I have knowledge of the facts, statements, and matters herein contained and the log of the above-described well as filed and that the same are true and correct. So help me God.

(Signature) Ralph Schuyler  
P. O. Box 355, Great Bend, Kansas  
(Address)

SUBSCRIBED AND SWORN TO before me this 9th day of September, 19 63

My commission expires December 14, 1965  
Elaine H. Taylor Notary Public.

D R I L L E R S   L O G

#1 Boling

CASING RECORD:  
227.60' used 8-  
5/8" surface  
casing.  
TOTAL DEPTH:  
4020'

CONTRACTOR: Strata Drilling, Inc.  
COMPANY: William H. Pine  
COMMENCED: August 26, 1963  
COMPLETED: September 3, 1963

DESCRIPTION: <sup>SW NE</sup> SE/4  
Section 29-22S-15W  
Pawnee County, Kansas

D. &amp; A.

| <u>FORMATION</u>   | <u>FROM</u> | <u>TO</u> | <u>REMARKS</u>   |
|--------------------|-------------|-----------|--|
| Sand               | 0           | 173       | Ran 227.60' of used 8-5/8" sur-<br>face casing; set and cemented at<br>235' with 225 sacks of regular<br>cement, 2% gel and 3% C. C.. Plug<br>down at 9:00 P. M. August 26,<br>1963. Cement circ.. |
| Shale              | 173         | 236       |  |
| Shale & Red Bed    | 236         | 375       |  |
| Shale & Red Bed    | 375         | 954       |  |
| Anhydrite          | 954         | 978       |  |
| Shale              | 978         | 1275      |  |
| Shale & Shells     | 1275        | 1850      |  |
| Lime               | 1850        | 2020      |  |
| Lime & Shale       | 2020        | 3380      |  |
| Lime               | 3380        | 3453      |  |
| Lime & Shale Sandy | 3453        | 3565      | Ran two drill stem tests.  |
| Lime & Shale       | 3565        | 3664      |  |
| Lime               | 3664        | 3815      |  |
| Lime & Shale       | 3815        | 3880      |  |
| Chert & Lime       | 3880        | 3988      |  |
| Lime               | 3988        | 4020      |  |
| Total Depth        | 4020        |           |  |

D. &amp; A.

Total Depth 4020'

**RECEIVED**  
STATE CORPORATION COMMISSION

SEP 13 1963

CONSERVATION DIVISION  
Wichita, Kansas

Hole plugged as follows: Plugged  
at 230' with 30 sacks of cement  
and  $\frac{1}{4}$  sack hulls and mud to 40';  
plugged with 10 sacks of cement  
and  $\frac{1}{4}$  sack of hulls. Job completed  
at 10:30 A. M. September 3, 1963.

STATE OF KANSAS )  
                          ) ss:  
COUNTY OF BARTON)

I certify that this is a true and correct copy of the above log to  
the best of my knowledge.

STRATA DRILLING, INC.

*Ralph Schuyler*  
Ralph Schuyler

Subscribed and sworn before me this 9th day of September, 1963.

My Commission Expires:  
December 14, 1965

*Elaine H. Taylor*  
Elaine H. Taylor, Notary Public