

STATE OF KANSAS
STATE CORPORATION COMMISSION

WELL PLUGGING RECORD

15-009-22496-0000

Give All Information Completely
Make Required Affidavit
Mail or Deliver Report to
Conservation Division
State Corporation Comm.
245 North Water
Wichita, KS 67202

BARTON

County, Sec. 32 Twp. 16 Rge. 11 W

Location as "NE/CNW $\frac{1}{2}$ /SW $\frac{1}{4}$ " or footage from lines
50' E SW SW SW

Lease Owner N.C.R.A.

Lease Name HITSCHMANN EST. Well No. 10

Office Address 404 Lincoln Towers Denver, Co. 80295

Character of Well (Completed as Oil, Gas or Dry Hole)

Dry Hole

Date Well completed November 7 1981

Application for plugging filed November 7 1981

Application for plugging approved November 7 1981

Plugging commenced 11:30 P.M. November 6 1981

Plugging completed 12:30 A.M. November 7 1981

Reason for abandonment of well or producing formation


If a producing well is abandoned, date of last production
19

Was permission obtained from the Conservation Division or
its agents before plugging was commenced? yes

Name of Conservation Agent who supervised plugging of this well Marion Schmidt

Producing formation Depth to top Bottom Total Depth of Well 3387'

Show depth and thickness of all water, oil and gas formations.

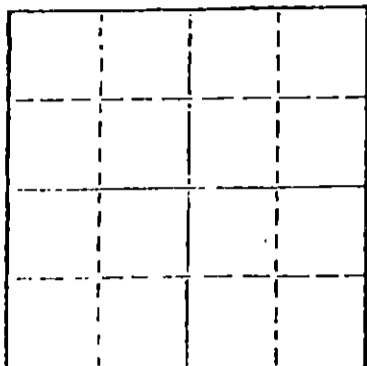

Locate well correctly on above
Section Plat

OIL, GAS OR WATER RECORDS

CASING RECORD

FORMATION	CONTENT	FROM	TO	SIZE	PUT IN	PULLED OUT

Describe in detail the manner in which the well was plugged, indicating where the mud fluid was placed and the method or methods used in introducing it into the hold. If cement or other plugs were used, state the character of same and depth placed, from _____ feet to _____ feet for each plug set.

- 70 sx. at 540'
- 40 sx. at 270'
- 10 sx. at 40'
- 10 sx. in rat hole

RECEIVED
STATE CORPORATION COMMISSION

NOV 18 1981
11-18-81

CONSERVATION DIVISION
Wichita, Kansas

(If additional description is necessary, use BACK of this sheet)

Name of Plugging Contractor L. D. Drilling, Inc.

STATE OF Kansas COUNTY OF Barton, ss.
Don Popp (employee of owner) or (~~owner~~)

of the above-described well, being first duly sworn on oath, says: That I have knowledge of the facts, statements, and matters herein contained and the log of the above-described well as filed and that the same are true and correct. So help me God.

(Signature) Don Popp
Hoisington, Kans. 67544
(Address)

SUBSCRIBED AND SWORN TO before me this 12th day of November, 19 81

Bessie M. DeWerff
Bessie M. DeWerff Notary Public.

My commission expires 5-50-85



24

DRILLERS WELL LOG

L. D. DRILLING, INC. - CONTRACTOR

N.C.R.A. - OPERATOR

HITSCHMANN EST. #10
50' E. SW-SW-SW
SEC. 32-16-14
BARTON COUNTY, KANSAS

T.D. 3387'
ELEVATION 1925' G.L.
1930' K.B.

COMMENCED: 10-31-81
COMPLETED: 11-06-81

CASING:

8 5/8" Set at 282'

CEMENT:

W/200 SX Common Cement 2% Gel, 3% CC

FORMATION:

Post Rock
Shale
Red Bed
Anhy
Shale
Lime and Shale

DEPTH:

0 - 70
70 - 540
540 - 780
780 - 806
806 - 1450
1450 - 3387

FORMATION TOPS: Sample

Heeb 2982' (-1052)
Toronto 3002' (-1072)
D. Sand 3021' (-1091)
B. Lime 3080' (-1150)
Lans K/C 3096' (-1166)
Arb. 3382' (-1452)

AFFIDAVIT

STATE OF KANSAS)
) SS
COUNTY OF BARTON)

I certify that this is a true and correct copy of the above log to the best of my knowledge.

RECEIVED
STATE CORPORATION COMMISSION
NOV 18 1981
CONSERVATION DIVISION
Wichita, Kansas

L. D. DRILLING, INC.

Don Popp
DON POPP

Sworn to and subscribed before me this 17th day of November, 1981.

Bessie M. DeWerff
BESSIE M. DEWERFF

My Appointment Expires:
5-20-85

