


STATE OF KANSAS
STATE CORPORATION COMMISSION

Give All Information Completely
Make Required Affidavit
Mail or Deliver Report to:
Conservation Division
State Corporation Commission
800 Blitting Building
Wichita, Kansas

WELL PLUGGING RECORD

OR 15-009-15099-0000
FORMATION PLUGGING RECORD (Strike out upper line when reporting plugging off formations.)

Barton County, Sec 32 Twp 16 Rge. 11(W)
Location as "NE $\frac{1}{4}$ NW $\frac{1}{4}$ SW $\frac{1}{4}$ " or footage from lines NE, NE, NW
Lease Owner The Derby Oil Company
Lease Name Dolechek Well No. 2
Office Address 420 West Douglas, Wichita, Kansas.
Character of Well (completed as Oil, Gas or Dry Hole) Oil Well
Date well completed February 26, 19 49
Application for plugging filed March 18, 19 49
Application for plugging approved March 22, 19 49
Plugging commenced April 13, 19 49
Plugging completed April 18, 19 49
Reason for abandonment of well or producing formation Oil can no longer be economically produced.
If a producing well is abandoned, date of last production February 19 49
Was permission obtained from the Conservation Division or its agents before plugging was commenced? Yes

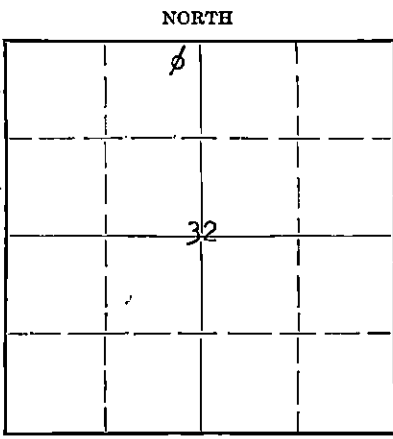

Locate well correctly on above Section Plat

Name of Conservation Agent who supervised plugging of this well Mr. Charles Stough.
Producing formation Arbuckle Depth to top 3330 Bottom 3353 Total Depth of Well 3353 Feet
Show depth and thickness of all water, oil and gas formations.

OIL, GAS OR WATER RECORDS

CASING RECORD

Formation	Content	From	To	Size	Put In	Pulled Out
Arbuckle	Oil	3330	3353	8 5/8"	519'	None
				5 1/2"	3333'	2716'

Describe in detail the manner in which the well was plugged, indicating where the mud fluid was placed and the method or methods used in introducing it into the hole. If cement or other plugs were used, state the character of same and depth placed, from feet to feet for each plug set.

Cement 3353 - 3305
Heavy mud 3305 - 250
Cement 250 - 205
Heavy mud 205 - 27
Cement 27 - 6
Cellar 6 - 0

RECEIVED
Conservation Div.
APR 27 1949 04-27-49
STATE CORPORATION COMMISSION
KANSAS

(If additional description is necessary, use BACK of this sheet)

Correspondence regarding this well should be addressed to The Derby Oil Company,
Address Box 1030, Wichita, Kansas.

STATE OF Kansas, COUNTY OF Sedgwick, ss.
J. R. Bratcher (employee of owner) or (owner or operator) of the above-described well,
being first duly sworn on oath, says: That I have knowledge of the facts, statements, and matters herein contained and the log of the above-described well as filed and that the same are true and correct. So help me God.

(Signature) J. R. Bratcher, Engineer,
Derby Oil Company, Wichita, Kansas.
(Address)

SUBSCRIBED AND SWORN to before me this 25th day of April 19 49.

My commission expires June 11, 1952.

Ruth L. Knouse
Ruth L. Knouse, Notary Public.

PLUGGING
FILE SEC 32 T 16 R 11W
BOOK PAGE 87 LINE 37

THE DERBY OIL COMPANY

Record of Well No. 2
 Location NE/C NW
 Contractor Kiowa Drilling Company
 Drilling Commenced 2-7-44
 Elevation 1905

Dolechek Farm
 Sec. 32 Twp. 16 S Rge. 11W
 County Barton
 State Kansas

Drilling Completed 2-26-44

CASING RECORD

SIZE	FEET	KIND	WEIGHT	
8 5/8"	549'	O.D.	28#	Cemented 200 sx. bulk cement (Halliburton)
5 1/2"	3333'	O.D.	14#	200# Calcium Chloride Cemented with 100 sx bulk cement.

FORMATION	BOTTOM	FORMATION	BOTTOM
Shale & sand	0 -		180
Shale & shells			280
Sand			335
Shale & shells			380
Hard sand & Pyrite			390
Shale & shells			549
Shale			640
Red bed			750
Anhydrite			780
Shale & shells			1230
Salt			1430
Shale & shells			1490
Shale & lime			2795
Lime			3330
Dol. chert			3353

GEOLOGICAL SURVEY

Tops:

Douglas sand 3004
 Lansing 3067
 Oolitic zone 3116
 Arbuckle 3330

T.D. 3353

CABLE TOOL RECORD

Tophead to flange on Braden-head 5'4"-2'3" lower than rotary table. Drill plug & drill deeper 3348. Small show oil 3344-48. Drill deeper 3353 TD. Increase oil 3351-53. Bail 1/3 bailer oil per hr. 5 hrs. 500A G.O. and swab down. Swab 26 fluid in 7 hrs. Run tubing and rods. Comp. for min. well.

RECEIVED
 APR 27 1949
 STATE CORPORATION COMMISSION
 KANSAS

PLUGGING

FILE REC-32716 R/11W

BOOK PAGE 87 LINE 37

FORMATION

BOTTOM

FORMATION

BOTTOM