

Give All Information Completely
Make Required Affidavit
Mail or Deliver Report to:
Conservation Division
State Corporation Commission
800 Bitting Building
Wichita, Kansas

Barton

County, Sec. 32 Twp 16 Rge. (E) 11 (W)

Location as "NE $\frac{1}{4}$ NW $\frac{1}{4}$ SW $\frac{1}{4}$ " or footage from lines. NE-SW-NE

Lease Owner. Sohio Petroleum Company

Lease Name. Rous

Well No. 12
AMB KC

Office Address. Box 609, Russell, Kansas

Character of Well (completed as Oil, Gas or Dry Hole) Dry Hole

Date well completed. 6/28/44 19.

Application for plugging filed. 6/28/44 telephone; 7/1/44 written 19.

Application for plugging approved. 6/28/44 by telephone 19.


Plugging commenced. 6/28/44 19.

Plugging completed. 6/29/44 19.

Reason for abandonment of well or producing formation. Dry hole

If a producing well is abandoned, date of last production. Dry hole 19.

Was permission obtained from the Conservation Division or its agents before plugging was commenced? Yes, from Eldon Petty of Great Bend, Ka.

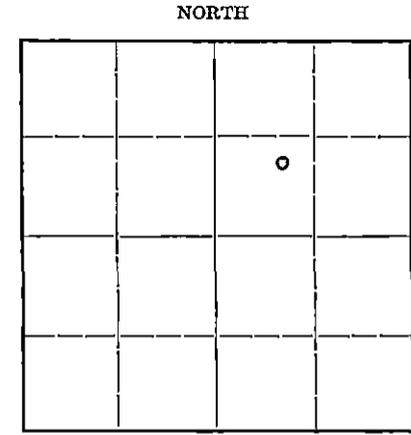

Locate well correctly on above Section Plat

Name of Conservation Agent who supervised plugging of this well. Eldon Petty, Great Bend, Kansas

Producing formation. Depth to top. Bottom. Total Depth of Well. 3386 Feet

Show depth and thickness of all water, oil and gas formations.

OIL, GAS OR WATER RECORDS

CASING RECORD

Formation	Content	From	To	Size	Put In	Pulled Out
No commercial oil or gas shows from top of hole to bottom.				8-5/8" O.D.	586'	None

Describe in detail the manner in which the well was plugged, indicating where the mud fluid was placed and the method or methods used in introducing it into the hole. If cement or other plugs were used, state the character of same and depth placed, from... feet to... feet for each plug set.

3386' to 590' mud & bridge
590' to 523' Cement (20 sacks)
Filled hole with water from 523' to top and welded cap on top of 8 5/8" casing.

Application to be filed at a later date for disposal well.

(If additional description is necessary, use BACK of this sheet)

Correspondence regarding this well should be addressed to. Sohio Petroleum Company

Address. Box 609, Russell, Kansas

STATE OF Kansas, COUNTY OF Russell, ss.

P. C. Musgrove

(employee of owner) or ~~owner~~ of the above-described well,

being first duly sworn on oath, says: That I have knowledge of the facts, statements, and matters herein contained and the log of the above-described well as filed and that the same are true and correct. So help me God.

(Signature)

P.C. Musgrove

Box 609, Russell, Kansas

(Address)

SUBSCRIBED AND SWORN to before me this 6th day of July 1944

Bernie J. Smith

Notary Public.

My commission expires May 8, 1948.



State

CONTRACTOR'S VERIFIED LOG

Operator Solio Petroleum Co. Farm Name Rous Well No. 2
 Location NE/4 SW/4 NE/4 Sec. 32-16S-11W.
 Pool Name Kraft-Prusa County Barton State Kansas
 Commencement Date 6-12-44 Completion Date 6-28-44

LOG OF WELL

Depth		Formation	Deviation from Vertical (Degrees)	Remarks
From	To			
0	125	Clay-Shale		
125	597	Shale-Red Rock	1/4°	
597	1480	Shale-Shells-Red Bed-Salt	0°	
1480	1780	Lime-Shale-Shells	0°	
1780	1970	Shale-Lime		
1970	2215	Lime-Shale	1/4°	
2215	2485	Shale-Shells		Top Topeka 2265'
2485	2685	Shale-Lime	1/4°	
2685	2870	Shale-Lime		
2870	3045	Lime	0°	
3045	3164	Shale-Lime		Top KC-Lansing 3062'
3164	3300	Lime		
3300	3386	Lime-Cherty Cong.	1/4°	Top Cherty Cong. 3346' Top Arbuckle 3365'

DIGGING
 FILE 32 16 11W
 BOOK PAGE 123 LINE 19

WARRANTY
 12-28-44
 11-1-44

