


STATE OF KANSAS
STATE CORPORATION COMMISSION

Give All Information Completely
Make Required Attestation
Mail or Deliver Report to:
Conservation Division
State Corporation Commission
212 No. Market
Wichita, Kansas

Form CP-4
15-167-03 007-0000
WELL PLUGGING RECORD

NORTH

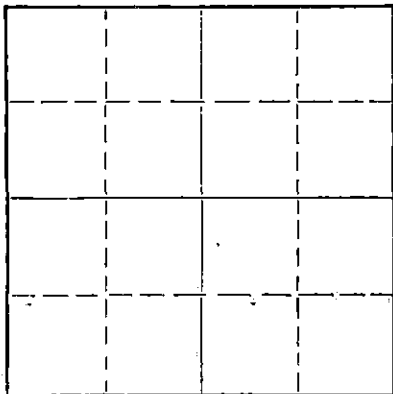

Locate well correctly on above
Section Plat

Russell County. Sec. ²⁵ 21 Twp. 14 Rge. 15 (E) (W)
Location as "NE/CNW%SW%" or footage from lines SW SW SW
Lease Owner Spector Pipe and Supply Inc.
Lease Name Harbaugh Well No. 1
Office Address Russell, Kansas
Character of Well (completed as Oil, Gas or Dry Hole) oil
Date well completed 4-4-51 19
Application for plugging filed July 26, 1966 19
Application for plugging approved July 27, 1966 19
Plugging commenced October 10, 1966 19
Plugging completed October 13, 1966 19
Reason for abandonment of well or producing formation failure to produce profitably

If a producing well is abandoned, date of last production 19
Was permission obtained from the Conservation Division or its agents before plugging was commenced? Yes

Name of Conservation Agent who supervised plugging of this well Don Truan
Producing formation ~~ARKANSAS~~ Gorham Sand Depth to top 3200 Bottom 3201 Total Depth of Well 3203 Feet
Show depth and thickness of all water, oil and gas formations.

OIL, GAS OR WATER RECORDS

CASING RECORD

FORMATION	CONTENT	SIZE	PUT IN	PULLED OUT
		8 5/8" OD	310 feet	none
		5 1/2" OD	3201 ft.	2011.34

Describe in detail the manner in which the well was plugged, indicating where the mud fluid was placed and the method or methods used in introducing it into the hole. If cement or other plugs were used, state the character of same and depth placed, from _____ feet to _____ feet for each plug set.

Plugged back with sand to 2900 feet and dumped 5 sacks of cement. Mudded hole to 315 feet. Set Rock Bridge and finished filling hole with ready-mix cement.

(If additional description is necessary, use BACK of this sheet)

Name of Plugging Contractor Lynch Casing Pulling Co. 457
Address R.F.D. 4, Great Bend, Kansas

STATE OF Kansas, COUNTY OF Russell, ss.
Spector Pipe & Supply, Inc. (employee of owner) or (owner or operator) of the above-described well, being first duly sworn on oath, says: That I have knowledge of the facts, statements, and matters herein contained and the log of the above-described well as filed and that the same are true and correct. So help me God.

(Signature) [Signature]
Russell, Kansas (Address)

SUBSCRIBED AND SWORN TO before me this 18th day of October, 1966

My commission expires May 21, 1967

[Signature]
Notary Public.

DUGLED

B & R Drilling, Inc.
Harbaugh No. 1

SW SW SW Section 24-14-15W
Russell County, Kansas

25-14-15W

Total Depth: 3203'
Comm: 3-21-51
Comp: 4- 4-51

Run 60 + 80

Casing

8 5/8" Set @ 816'
5 1/2" Set @ 3201'

Cement

400 Sacks of Bulk
100 Sacks of Ash Grove

Class 1792

Formation

Depth

Surface Soil-Clay	20
Sand	60
Shale-Shells	110
Sand	150
Shale-Shells-Pyrite	210
Sand	240
Shale-Shells-Pyrite	350
Sand	415
Shale-Shells	510
Shale-Red Bed	808
Anhydrite	820
Come out of hole-Started Reaming 7 7/8" hole to 12 1/4.	
Surface Clay	20
Sand-Shale-Shells	285
Shale-Shells-Pyrite	350
Sand	415
Shale-Shells	510
Shale-Red Bed	585
Shale-Shells-Red Bed	800
Red bed	808
Anhydrite	838
Red Bed	920
Shale-Shells	1500
Shale-Salt	1580
Shale-Shells	1850
Lime-Shale	1905
Shale-Lime	2950
Lime	3020
Shale-Lime	3045
Lime	3203

RECEIVED
STATE CORPORATION COMMISSION
JUL 27 1966
CONSERVATION DIVISION
Wichita, Kansas

copy as is here

copy as is

Bona-Bount
Heebner 2910
Samsing 2967
Dorchard
sand 3200

STATE OF KANSAS)
)SS
RUSSELL COUNTY)

I hereby certify that the above information is true and correct to the best of my knowledge.

Walter Keller

Subscribed and sworn to before me this 13th day of April, 1951.

Charles L. Lamm
Notary Public

My commission expires: 6-17-54