

15-155-62282-6000

STATE OF KANSAS
STATE CORPORATION COMMISSION

WELL PLUGGING RECORD

Give All Information Completely
Make Required Affidavit
Mail or Deliver Report to:
Conservation Division
State Corporation Commission
800 Bitting Building
Wichita, Kansas


OR

FORMATION PLUGGING RECORD

Strike out upper line
when reporting plug-
ging off formations.

Reno County, Sec. 31 Twp. 23S Rge. (E) 10 (W)

Location as "NE $\frac{1}{4}$ NW $\frac{1}{4}$ SW $\frac{1}{4}$ " or footage from lines NW NW
Lease Owner The Texas Company
Lease Name F. McNickle Well No. 1
Office Address 614 Bitting Bldg., Wichita, Kansas
Character of Well (completed as Oil, Gas or Dry Hole) Oil
Date well completed 10-21-19 44
Application for plugging filed 8-2-19 49
Application for plugging approved 8-2-19 49
Plugging commenced 8-11-19 49
Plugging completed 8-12-19 49
Reason for abandonment of well or producing formation Well ceased to be a commercial producer
If a producing well is abandoned, date of last production February, 19 49
Was permission obtained from the Conservation Division or its agents before plugging was commenced? Yes

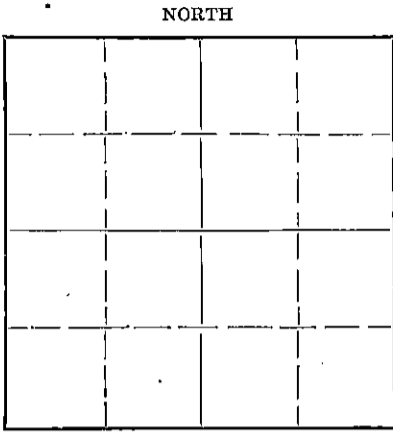

Locate well correctly on above Section Plat

Name of Conservation Agent who supervised plugging of this well Ruel Durkee
Producing formation Viola Depth to top Bottom Total Depth of Well 3750 Feet
Show depth and thickness of all water, oil and gas formations.

OIL, GAS OR WATER RECORDS

CASING RECORD

Formation	Content	From	To	Size	Put In	Pulled Out
				10-3/4"	167'	0
				7"	3749'	1755'

Describe in detail the manner in which the well was plugged, indicating where the mud fluid was placed and the method or methods used in introducing it into the hole. If cement or other plugs were used, state the character of same and depth placed, from feet to feet for each plug set.

Lane Wells Plug at 3482'
Plugged with heavy mud from Lane Wells Plug to 230'
Set rock bridge from 230' to 225'
Plugged with 25 sacks cement from 225' to 180'
" " heavy mud from 180' to 15'
" " 5 sacks cement from 15' to bottom of cellar
" " surface clay from bottom of cellar to ground level

8-18-49

RECEIVED

Conservation Div.

AUG 18 1949

STATE CORPORATION
COMMISSION

KANSAS

(If additional description is necessary, use BACK of this sheet)

Correspondence regarding this well should be addressed to The Texas Company
Address 614 Bitting Bldg., Wichita, Kansas

STATE OF Kansas, COUNTY OF Sedgwick, ss.

M. C. Harrell (employee of owner) or (owner or operator) of the above-described well, being first duly sworn on oath, says: That I have knowledge of the facts, statements, and matters herein contained and the log of the above-described well as filed and that the same are true and correct. So help me God.

(Signature) M. C. Harrell


614 Bitting Bldg., Wichita, Kansas (Address)

SUBSCRIBED AND SWORN to before me this 17th day of August, 19 49

H. Howard Kistler Notary Public.

My commission expires September 20, 1952

22-2625 2-48-15M

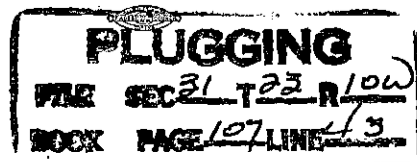

LOG OF WELL

15-155-02282-0000

SHEET

OWNER The Texas Company DIVISION Oklahoma-Kansas DATE MADE November 15, 1944
 DISTRICT Kansas LEASE F. McNickle WELL NO. 1
 STATE Kansas COUNTY OR PARISH Reno TWP. 23S RANGE 10W SEC. 31
 LOCATION OF WELL NW NW

COMMENCED RIGGING UP 9/17/44 COMMENCED DRILLING 9/18/44 COMPLETED DRILLING 10/21/44
 DAY DRILLER _____ NIGHT DRILLER _____ CONTRACTOR Hissom Drlg. Co.
 CABLE FROM _____ TO _____ ROTARY FROM 0 TO 3750' COMPANY RIG NO. _____
 TOTAL DEPTH 3750 MEASURED BY _____ ELEVATION 1800

CASING RECORD

SIZE	WEIGHT	PUT IN WELL		PULLED OUT		LOST IN WELL		SHOES		PACKERS		
		FEET	INS.	FEET	INS.	FEET	INS.	LENGTH	MARK	KIND	LENGTH	SET AT
10-3/4"	29#	167				cemented w/ 200		sax cement				FT.
7" OD	20#	3749				cemented w/ 100		sax cement				FT.
												FT.
												FT.
												FT.
												FT.
												FT.
												FT.
												FT.

WAS CASING CEMENTED? _____ IF SO, HOW MANY SACKS OF CEMENT USED? _____
 LINER: STATE SIZE AND WEIGHT _____ WHERE SET _____ FT. AND INS. BLANK _____ FT. AND INS. PERFORATED _____
 HOW PUT TOGETHER _____ COUPLING _____ FLUSH-JOINT _____ INSERTED _____
 REMARKS: _____

EQUIPMENT RECORD

TUBING				SUCKER RODS			PUMPING OUTFIT
SIZE	WEIGHT	FEET	INS.	FEET	INS.	SIZE AND KIND	DESCRIPTION, KIND, SIZE, ETC.

FLOWING, PUMPING, GASSEY OR DRY Flow PRODUCTION FIRST 24 HOURS 2521 PRODUCTION SETTLED _____
 IF GAS WELL, OPEN FLOW CAPACITY _____ SHUT IN PRESSURE _____ ROCK PRESSURE _____
 KIND OF SHOT _____ SIZE OF SHOT, QUARTS _____
 NUMBER OF SHELLS _____ SIZE OF SHELLS _____ INCHES DIAMETER _____
 LENGTH OF SHELLS _____ FEET _____ INCHES _____ TOP OF SHOT _____
 BOTTOM OF SHOT _____ ANCHOR _____ WELL BRIDGED TO _____
 TOTAL DEPTH OF WELL _____ NUMBER OF SHOT _____ PRODUCTION BEFORE SHOT _____ BBLs. PER DAY _____
 PRODUCTION AFTER SHOT _____ BBLs. PER DAY. SHOT FURNISHED BY _____
 NAME OF SHOOTER _____ SHOT INSPECTED _____ BY _____ (COMPANY EMPLOYEE)
 COMMENCED DRILLING DEEPER _____ COMPLETED _____ DRILLING DEEPER _____
 TOTAL DEPTH _____ PRODUCTION FIRST 24 HOURS _____ PRODUCTION SETTLED _____

REMARKS: Perf 3706-10 w/ 15 shots, flow 160 oil in 1-1/4 hrs - Tops: Any 460', Lansing 3297', Cong 3591', Misner 3661', Viola 3668'

NOTE: IF WELL WAS DRY, STATE UNDER WHAT CONDITIONS WHEN, HOW, AND BY WHOM PLUGGED. STATE UNDER REMARKS ANYTHING NOT COVERED IN LOG. IF THE SPACE PROVIDED FOR REMARKS IS NOT SUFFICIENT WRITE ON BOTTOM OF LAST SHEET OF LOG.

PLUGGING
 PERM 23 R 10W
 BOOK PAGE 107 LINE 43

LOG OF WELL

SHEET No. 2

15-155-62282-0000

District Kansas

Owner The Texas Company Farm F. McNickle

Well No. 1

FORMATION	AMOUNT	COLOR	HARD OR SOFT	DEPTH CORES TAKEN	REMARKS
Sand	110				
Sand & Red Rock	164				
Red Bed	480				
Anhydrite	520				
Shale & Shells	1050				
Salt & Shells	1150				
Shale & Shells	1395				
Shale & Lime	1695				
Sand & Lime	1705				
Shale & Lime	1970				
Lime	2030				
Lime & Shale	2498				
Lime	2550				
Lime & Shale	2876				
Lime	3110				
Lime & Shale	3198				
Lime	3396				
Lime & Chert	3436				
Lime	3682				
Lime & Chert	3750	T.D.			