

WELL PLUGGING RECORD

Give All Information Completely  
Make Required Affidavit  
Mail or Deliver Report to:  
Conservation Division  
State Corporation Commission  
211 No. Broadway  
Wichita, Kansas

Hodgeman County. Sec. 15 Twp. 22 Rge. 23 (E) W (W)

Location as "NE/CNW/SW" or footage from lines C SW SE

Lease Owner Mull Drilling Company, Inc.

Lease Name Armstrong Well No. 1

Office Address 1625 Wichita Plaza, Wichita, Kansas

Character of Well (completed as Oil, Gas or Dry Hole) Oil

Date well completed 9-5-63 19

Application for plugging filed 10-10-66 19

Application for plugging approved 10-11-66 19


Plugging commenced 10-31-66 19

Plugging completed 10-31-66 19

Reason for abandonment of well or producing formation  
No oil production

If a producing well is abandoned, date of last production 12-16-64 19

Was permission obtained from the Conservation Division or its agents before plugging was commenced? yes

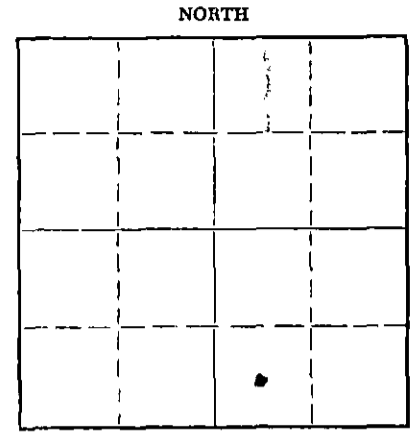

Locate well correctly on above Section Plat

Name of Conservation Agent who supervised plugging of this well E. Eves

Producing formation Mississippian Depth to top 4568 Bottom \_\_\_\_\_ Total Depth of Well 4585 Feet

Show depth and thickness of all water, oil and gas formations.

OIL, GAS OR WATER RECORDS

CASING RECORD

FORMATION	CONTENT	FROM	TO	SIZE	PUT IN	PULLED OUT
Mississippian	oil & water	4568	4585	4 1/2"	4580	none
				8 5/8"	287	

Describe in detail the manner in which the well was plugged, indicating where the mud fluid was placed and the method or methods used in introducing it into the hole. If cement or other plugs were used, state the character of same and depth placed, from \_\_\_\_\_ feet to \_\_\_\_\_ feet for each plug set.

30 sx. cement and hulls pumped to 4100'.  
Mud from 4100' to 600'.  
50 sx. cement 600' to surface.  
Standing pressure on last plug -- 1500#.  
Total 80 sx. cement used.

RECEIVED  
STATE CORPORATION COMMISSION

NOV 2 1966

CONSERVATION DIVISION  
Wichita, Kansas

(If additional description is necessary, use BACK of this sheet)

Name of Plugging Contractor Mull Drilling Company, Inc.

Address 1625 Wichita Plaza, Wichita, Kansas

STATE OF KANSAS, COUNTY OF SEDGWICK, ss.

R. M. Albers (employee of owner) or (owner or operator) of the above-described well, being first duly sworn on oath, says: That I have knowledge of the facts, statements, and matters herein contained and the log of the above-described well as filed and that the same are true and correct. So help me God.

(Signature) R M Albers  
1625 Wichita Plaza, Wichita, Kansas  
(Address)

SUBSCRIBED AND SWORN TO before me this 1st day of November, 19 66

My commission expires February 23, 1968

Betty Baker  
Notary Public.

ROTARY DRILLING LOG

OPERATOR: Rains & Williamson Oil Co.  
#1 ARMSTRONG  
C SW SE Sec. 15-22S-23W  
Hodgeman County, Kansas

CONTRACTOR: Rains & Williamson  
Oil Co.  
COMMENCED: 8-14-63  
COMPLETED: 8-26-63

Remarks: Set 8-5/8" casing at  
287' cmt. with 175  
sacks quick cement

FORMATIONS

Shale	450'
Sand	490'
Shale and Red Bed	925'
Anhydrite	940'
Shale	1015'
D. Sand	1230'
Shale and Red Bed	1545'
Anhydrite	1575'
Shale and Shells	2475'
Shale and Lime	2700'
Lime and Shale	3440'
Shale and Lime	3930'
Lime and Shale	4100'
Lime	4565'
Lime and Chert	4580'
Lime	4585'
 Rotary Total Depth	 4585'

RECEIVED  
STATE CORPORATION COMMISSION  
NOV 2 1966  
CONSERVATION DIVISION  
Wichita, Kansas

We certify the above log is  
true and correct to the best  
of our knowledge and belief.

RAINS & WILLIAMSON OIL CO.

Wilson Rains  
Wilson Rains  
Partner

Subscribed and sworn to before me, a  
Notary Public in and for the State  
of Kansas, County of Sedgwick, this  
30th day of August, 1963.

Sherry Gish  
Sherry Gish Notary Public

My Commission Expires:  
November 8, 1966

