

STATE OF KANSAS
STATE CORPORATION COMMISSION

WELL PLUGGING RECORD

Give All Information Completely
Make Required Affidavit
Mail of Deliver Report to:
Conservation Division
State Corporation Commission
211 No. Broadway
Wichita, Kansas

Hodgeman County, Sec. 11, Twp. 22S, Rge. 23W (E)xxxx(W)

Location as "NE/CNW/SW" or footage from lines C/SW $\frac{1}{2}$ NE $\frac{1}{2}$

Lease Owner Mahoney Drilling Company

Lease Name Ewy Well No. No. 1

Office Address 925 Sutton Place, 209 E. William, Wichita, KS 67202

Character of Well (completed as Oil, Gas or Dry Hole) Dry Hole

Date well completed 11/18/76 19

Application for plugging filed 12/7/76 19

Application for plugging approved 19


Plugging commenced 11/18/76 19

Plugging completed 11/18/76 19

Reason for abandonment of well or producing formation depleted

If a producing well is abandoned, date of last production 19

Was permission obtained from the Conservation Division or its agents before plugging was commenced?

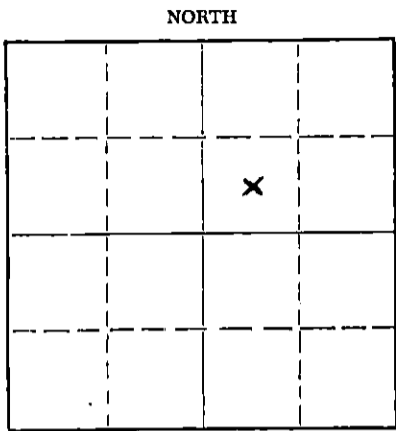

Locate well correctly on above Section Plat

Name of Conservation Agent who supervised plugging of this well Clarence Thomas, Jr.

Producing formation _____ Depth to top _____ Bottom _____ Total Depth of Well 4633' Feet

Show depth and thickness of all water, oil and gas formations.

OIL, GAS OR WATER RECORDS

CASING RECORD

FORMATION	CONTENT	FROM	TO	SIZE	PUT IN	PULLED OUT
			291	8 5/8"	284.36'	None

Describe in detail the manner in which the well was plugged, indicating where the mud fluid was placed and the method or methods used in introducing it into the hole. If cement or other plugs were used, state the character of same and depth placed, from _____ feet to _____ feet for each plug set.

1st plug @ 900' with 50 saxs.

2nd plug @ 290' with 35 saxs.

3rd plug @ 40' with 15 saxs.

5 saxs put in hole.

RECORDED
DATE FOR RECORD COMMISSION

DEC 08 1976 12-8-76

CONSERVATION DIVISION
Wichita, Kansas

(If additional description is necessary, use BACK of this sheet)

Name of Plugging Contractor Gabbert-Jones, Inc.

Address 830 Sutton Place, 209 E. William, Wichita, KS 67202

STATE OF KANSAS, COUNTY OF SEDGWICK, ss.

F. W. Mallonee, operator (employee of owner) or (owner or operator) of the above-described


well, being first duly sworn on oath, says: That I have knowledge of the facts, statements, and matters herein contained and the log of the above-described well as filed and that the same are true and correct. So help me God.

(Signature) FWM Mallonee

925 Sutton Place, 209 E. William, Wichita, KS 67202 (Address)

SUBSCRIBED AND SWORN to before me this 7th day of December, 1976

My commission expires April 1, 1978

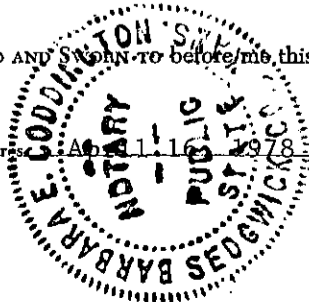

Barbara E. Coddington, Notary Public.

GABBERT-JONES, INC.
WICHITA, KANSAS
DRILLERS' WELL LOG

Ewy
SW-NE Sec 11-22S-23W
Hodgeman County, Kansas

Commenced: 11-5-76

Completed: 11-18-76

OPERATOR: MAHONEY DRILLING CO.

Depth		Formation	Remarks
From	to		
0	40	Surface Clay-Post Rock	Ran 7 jts of 23# 8 5/8" csg
40	88	Post Rock	set @ 291' Cemented w/175
88	115	Shale-Shells	skt Common 2% Gel
115	295	Shale-Sand	3% CC PD @ 1:15 a.m.
295	1000	Shale	11-6-76
1000	1210	Sand	
1210	1542	Shale-Redbed	
1542	1579	Anhy	
1579	1885	Shale-Shells	
1885	2375	Shale-Lime	
2375	3750	Lime-Shale	
3750	4625	Lime	
	4625 - TD		DRY & ABANDONED

STATE OF KANSAS)
) SS
COUNTY OF SEDGWICK)

I, the undersigned, being duly sworn on oath, state that the above Drillers Well Log is true and correct to the best of my knowledge and belief and according to the records of this office.

GABBERT-JONES, INC.

James S. Sutton II
JAMES S. SUTTON II

Subscribed and sworn to before me this 23rd day of November, 1976.

Elizabeth J. Edwards
ELIZABETH J. EDWARDS-NOTARY PUBLIC

My Commission expires February 6, 1979.



RECEIVED
STATE CORPORATION COMMISSION

DEC 08 1976

CONSERVATION DIVISION
Wichita, Kansas