

STATE OF KANSAS
STATE CORPORATION COMMISSION

Give All Information Completely
Make Required Affidavit
Mail or Deliver Report to:
Conservation Division
State Corporation Commission
212 No. Market
Wichita, Kansas

WELL PLUGGING RECORD

Hodgeman County. Sec. 14 Twp. 22S Rge. (E) 23W (W)

Location as "NE/CNW%SW%" or footage from lines 150' NW of NW 1/4 NE 1/4

Lease Owner Birmingham-Bartlett Drilling Co.

Lease Name Dixon "A" Well No. 1

Office Address 300 Kaufman Bldg., Wichita, Kansas, 67202

Character of Well (completed as Oil, Gas or Dry Hole) Dry Hole

Date well completed September 22, 19 67

Application for plugging filed (verbally approved) September 25, 19 67

Application for plugging approved (" ") 19


Plugging commenced September 22, 19 67

Plugging completed September 22, 19 67

Reason for abandonment of well or producing formation _____

If a producing well is abandoned, date of last production _____ 19 _____

Was permission obtained from the Conservation Division or its agents before plugging was commenced? Yes

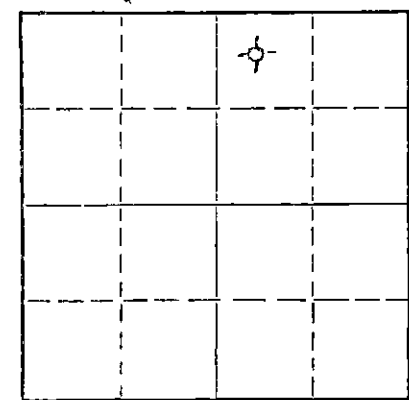

Locate well correctly on above Section Plat

Name of Conservation Agent who supervised plugging of this well Harold Hollis (info given later to Edgar J. Eves)

Producing formation _____ Depth to top _____ Bottom _____ Total Depth of Well 4579 Feet

Show depth and thickness of all water, oil and gas formations.

OIL, GAS OR WATER RECORDS

CASING RECORD

FORMATION	CONTENT	FROM	TO	SIZE	PUT IN	PULLED OUT
		0	362'	8-5/8"	362'	None

Describe in detail the manner in which the well was plugged, indicating where the mud fluid was placed and the method or methods used in introducing it into the hole. If cement or other plugs were used, state the character of same and depth placed, from _____ feet to _____ feet for each plug set.

Bottom plug set at 1165'
Halliburton cemented thru drill pipe with 100 sacks Posmix
Cement came up to approximately 800'
Middle plug set at 355' with 25 sacks cement up to 265'
Top plug set at 40' with approx. 12 to 14 sacks cement which filled
surface casing up to base of cellar.
Casing cut off & steel plate welded over top.

9-27-67

RECEIVED
STATE CORPORATION COMMISSION

SEP 27 1967

(If additional description is necessary, use BACK of this sheet)

Name of Plugging Contractor Birmingham-Bartlett Drilling Co. CONSERVATION DIVISION
Wichita, Kansas

Address (given above)

STATE OF KANSAS COUNTY OF SEDGWICK ss.
Richard Hindery, partner of Birmingham-Bartlett Drilling Co., owner & operator
(employee of owner) or (owner or operator) of the above-described

well, being first duly sworn on oath, says: That I have knowledge of the facts, statements, and matters herein contained and the log of the above-described well as filed and that the same are true and correct. So help me God. BIRMINGHAM-BARTLETT DRILLING CO.

(Signature) BY Richard Hindery
Partner
300 Kaufman Bldg., Wichita, Kansas, 67202
(Address)

SUBSCRIBED AND SWORN TO before me this 25th day of September 1967

My commission expires November 29, 1970

Vivian F. Yinger
Notary Public.

DIXON "A" NO. 1 WELL

LOCATION: 150' NW of NW $\frac{1}{4}$ NE $\frac{1}{4}$
 Sec. 14-22S-23W
 Hodgeman County, Kansas

SPUDED: 9-11-67

SURFACE CASING: 8-5/8" OD 28# Used Casing
 cemented at 362' with
 225 sacks quick set cement.

DRILLING
 COMPLETED: 9-22-67

OIL STRING: None Set. Dry Hole.
 Plugged 9-22-67

OWNER, OPERATOR
 and CONTRACTOR: Birmingham-Bartlett Drilling Co.
 300 Kaufman Building
 Wichita, Kansas, 67202

LOG

(Figures indicate bottom of formation)

0 -	40	Shale with rock
	255	Shale and Shells
	325	Sandy Shale
	362	Shale
	855	Shale and Sand
	970	Shale and Shells
	1165	Sand
	1518	Red Bed
	1554	Anhydrite
	1945	Shale and Shells
	2300	Shale with Lime
	2600	Shale and Lime
	2725	Lime
	3970	Lime and Shale
	4579	Lime
	4579	Rotary Total Depth Dry Hole

The undersigned, Richard Hindery, one of the partners of Birmingham-Bartlett Drilling Co., hereby certifies that the above is a true and correct log on the DIXON "A" NO. 1 WELL, as shown in the daily drilling reports.

BIRMINGHAM-BARTLETT DRILLING CO.

By Richard Hindery
 Richard Hindery, Partner

Subscribed and sworn to before me
 this 25th day of September, 1967.

Vivian F. Yinger
 Vivian F. Yinger, Notary Public

My commission expires November 29, 1970.

RECEIVED
 CONSERVATION COMMISSION

SEP 27 1967

CONSERVATION DIVISION
 Wichita, Kansas