


STATE OF KANSAS
STATE CORPORATION COMMISSION

WELL PLUGGING RECORD

Give All Information Completely
Make Required Affidavit
Mail or Deliver Report to
Conservation Division
State Corporation Comm.
245 North Water
Wichita, KS 67202

Hodgeman County. Sec. 14 Twp. 22S Rge. 23 E/W
Location as "NE/CNW $\frac{1}{4}$ SW $\frac{1}{4}$ " or footage from lines _____
2020' FNL & 630' FWL of NE/4
Lease Owner Buttonwood Petroleum, Inc.
Lease Name DIXON Well No. 1
Office Address Box 1869, Liberal, Kansas 67901
Character of Well (Completed as Oil, Gas or Dry Hole) _____
dry hole

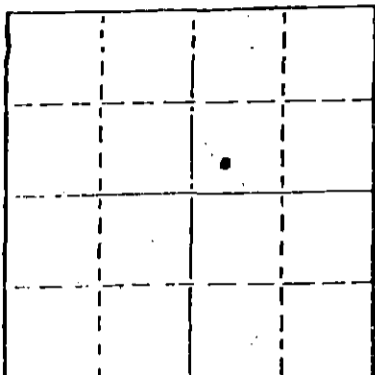

Locate well correctly on above
Section Plot

Date Well completed 11-22 1980
Application for plugging filed 1-26 1981
Application for plugging approved 1-28 1981
Plugging commenced 2-6 1981
Plugging completed 2-13 1981
Reason for abandonment of well or producing formation _____
dry hole

If a producing well is abandoned, date of last production
N/A 19

Was permission obtained from the Conservation Division or
its agents before plugging was commenced? yes

Name of Conservation Agent who supervised plugging of this well Clarence Thomas
Producing formation Oswego Depth to top 4561 Bottom 4573 Total Depth of Well 4675'
Show depth and thickness of all water, oil and gas formations.

OIL, GAS OR WATER RECORDS

CASING RECORD

FORMATION	CONTENT	FROM	TO	SIZE	PUT IN	PULLED OUT
				8 5/8"	463'	none
				4 1/2"	4675'	3333

Describe in detail the manner in which the well was plugged, indicating where the mud fluid
was placed and the method or methods used in introducing it into the hold. If cement or other
plugs were used, state the character of same and depth placed, from _____ feet to
_____ feet for each plug set.

Pumped 20 sacks of cement and 1 sack of hulls from 4573' to 4400'; pumped 50 sacks of cement
from 900' to 800'; pumped 35 sacks of cement from 480' to 380'; put 10 sacks of cement from
40' to 0' - cut off and capped 8 5/8" surface casing 3' below ground level.


2-25-81
STATE CORPORATION COMMISSION
FEB 25 1981
Conservation Division
Wichita, Kansas

(If additional description is necessary, use BACK of this sheet)
Name of Plugging Contractor Sargents Casing Pulling Service, PO Box 506, Liberal, Kansas #511

STATE OF KANSAS COUNTY OF SEWARD, ss.
C. E. Smith (employee of owner) or (owner or operator)
of the above-described well, being first duly sworn on oath, says: That I have knowledge of
the facts, statements, and matters herein contained and the log of the above-described well
as filed and that the same are true and correct. So help me God.

(Signature) C. E. Smith, Agent
Box 1869, Liberal, Kansas 67901
(Address)

SUBSCRIBED AND SWORN TO before me this 24th day of February, 19 81

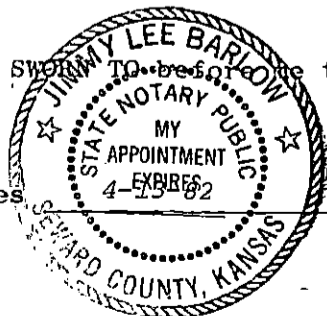

My commission expires _____

Jimmy Lee Barlow
Notary Public.

RECEIVED DEC 08 1980

API No. 15-083-20,782-0000

KANSAS DRILLERS LOG

COMPANY Buttonwood Petroleum, Inc.

SEC. 14 T. 22S R. 23W
LOC. 2020' FNL & 630' FWL

FARM Dixon NO. 1

COUNTY Hodgeman

ROTARY TOTAL DEPTH 4,675'
COMM. November 11, 1980 COMP. November 22, 1980
CONTRACTOR Freeman Drilling (Rig #1)
ISSUED December 4, 1980

CASING

10 3/4"
8 5/8" Set at 463' cemented w/250 sxs cement
5 1/2"
4 1/2" Set at 4,674' cemented w/200 sxs cement

ELEVATION 2,323' K.B.

FIGURES INDICATE BOTTOM OF FORMATIONS

Shale	2,891'
Lime and Shale	4,675'
Rotary Total Depth	4,675'

I hereby certify the above and foregoing to be a true and correct log of the above described well as shown by the drilling reports.

Freeman Drilling Company

Dean Britting
Dean Britting

State of Kansas)
) ss:
County of Sedgwick)

Subscribed and Sworn to before me a Notary Public in and for said county and state this 4th day of December, 1980.

Elsie Willison
Elsie Willison - Notary Public

My Commission Expires:

July 25, 1982

RECEIVED
STATE COMMISSION

JAN 28 1981

CONSERVATION COMMISSION
Wichita, Kansas