

WELL PLUGGING RECORD

Give All Information Completely
Make Required Affidavit
Mail or Deliver Report to:
Conservation Division
State Corporation Commission
800 Bittling Building
Wichita, Kansas

Pawnee County. Sec. 5 Twp. 22 Rge. (E) 16 (W)

Location as "NE/CNW/SW" or footage from lines. 399.5' E of W line & 115' S
Of E-W Quarter Line

Lease Owner Musgrove Petroleum Corporation

Lease Name THEIS Well No. 1

Office Address 801 Union Center, Wichita, Kansas

Character of Well (completed as Oil, Gas or Dry Hole) Dry

Date well completed August 20 19 56

Application for plugging filed verbally - August 19, 19 56

Application for plugging approved verbally - August 19, 19 56


Plugging commenced August 20, 19 56

Plugging completed August 20, 19 56

Reason for abandonment of well or producing formation Dry

If a producing well is abandoned, date of last production 19

Was permission obtained from the Conservation Division or its agents before plugging was commenced? verbally - yes.

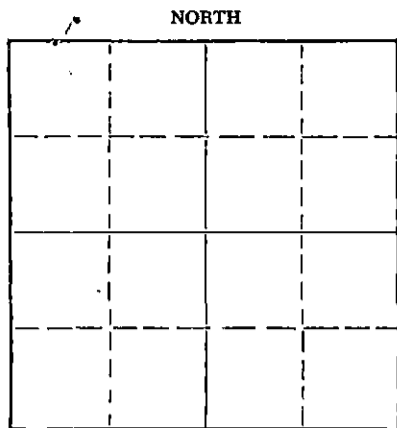

Locate well correctly on above Section Plat

Name of Conservation Agent who supervised plugging of this well

Producing formation Depth to top. Bottom Total Depth of Well 3915 Feet

Show depth and thickness of all water, oil and gas formations.

OIL, GAS OR WATER RECORDS

CASING RECORD

FORMATION	CONTENT	FROM	TO	SIZE	PUT IN	PULLED OUT
				8-5/8"	980'	

Describe in detail the manner in which the well was plugged, indicating where the mud fluid was placed and the method or methods used in introducing it into the hole. If cement or other plugs were used, state the character of same and depth placed, from feet to feet for each plug set.

Filled hole with heavy mud.
Set 1st plug at 350' w/ 1/2 sk hulls & Halliburton plug, and 30 sx cement.

Filled hole with heavy mud.
Set 2nd plug at 40' w/ 1/2 sk hulls & Halliburton plug and 10 sx cement.

8-25-56

(If additional description is necessary, use BACK of this sheet)

Name of Plugging Contractor Musgrove Petroleum Corporation

Address 801 Union Center, Wichita, Kansas.

STATE OF Kansas, COUNTY OF Sedgwick, ss.

I, Gordon L. Koelling (employee of owner) or (owner/operator) of the above-described well, being first duly sworn on oath, says: That I have knowledge of the facts, statements, and matters herein contained and the log of the above-described well as filed and that the same are true and correct. So help me God.

(Signature) Gordon L. Koelling

801 Union Center, Wichita, Kansas

(Address)

SUBSCRIBED AND SWORN to before me this 24th day of August, 19 56

Leah Joyce Hefke

Notary Public.

My commission expires June 16, 1959.

PLUGGING
FILE SEC. 5 T. 22 R. 16W
BOOK PAGE 92 LINE 7

CONTRACTOR'S WELL LOG

COMPANY: Musgrove Petroleum Corporation
 CONTRACTOR: Musgrove Petroleum Corporation
 FARM: THEIS #1 *NWNW S.W*
 LOCATION: 399.5' East of West Line & 115' South of East-West Quarter Line, Section 5-22-16, Pawnee County, Kansas
 COMMENCED: August 8, 1956
 COMPLETED: August 20, 1956

0	40	Surface soil & sand
40	70	Sand
70	435	Shale & shells
435	535	Sand
535	885	Shale
885	974	Shale & shells
974	1020	Anhydrite
1020	1150	Shale
1150	1935	Shale & shells
1935	1960	Lime & shale
1960	2255	Lime
2255	3200	Lime & shale
3200	3445	Lime
3445	3495	Shale
3495	3852	Lime
3852	3885	Shale & lime
3885	3915	Lime
	3915	Rotary Total Depth

Set 8-5/8" surface pipe at 980' with 500 sx Posmix, 2% calcium chloride.
 Dry and Abandoned.

ELEVATION:	2004' K. B.	Brown Lime	3512'	(-1508)
Schlumberger Tops:		Lansing	3521'	(-1517)
Heebner	3410' (-1406)	Conglomerate	3856'	(-1852)
Toronto	3430' (-1426)	Arbuckle	3880'	(-1876)
Douglas	3447' (-1443)			

STATE OF KANSAS)
) SS
 COUNTY OF SEDGWICK)

I, GORDON L. KOELLING, do hereby certify that the above and foregoing is a true and correct copy of the log of the THEIS #1, 399.5' East of the West Line and 115' South of the East/West Quarter Line of Section 5-22-16, Pawnee County, Kansas, as reflected by the files of the Musgrove Petroleum Corporation,

MUSGROVE PETROLEUM CORPORATION

BY *Gordon L. Koelling*
 Secretary-Treasurer

Subscribed and sworn to before me, a Notary Public, in and for Sedgwick County, Kansas, this 24th day of August, 1956.

PLUGGED
 FILE SEC 5 T 22 R 16 W
 BOOK PAGE 22 LINE 2

Dean J. H. Hays
 Notary Public

My commission expires June 16, 1959.