


STATE OF KANSAS  
STATE CORPORATION COMMISSION

WELL PLUGGING RECORD

Give All Information Completely  
Make Required Affidavit  
Mail or Deliver Report to  
Conservation Division  
State Corporation Comm.  
245 North Water  
Wichita, KS 67202

Pawnee County, Sec. 2 Twp. 22S Rge. 16W E/W  
Location as "NE/CNW $\frac{1}{4}$ /SW $\frac{1}{4}$ " or footage from lines NW SE NE

Lease Owner D.R. Lauck Oil Company, Inc.  
Lease Name Wurm Well No. 1  
Office Address 221 S. Broadway, Suite 400, Wichita, KS 67202  
Character of Well (Completed as Oil, Gas or Dry Hole) Dry Hole

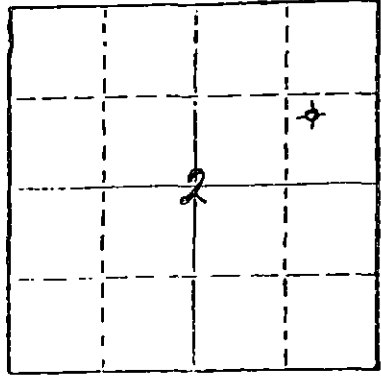

Locate well correctly on above  
Section Plat

Date Well completed October 18, 1980  
Application for plugging filed October 18, 1980  
Application for plugging approved October 18, 1980  
Plugging commenced October 18, 1980  
Plugging completed October 18, 1980  
Reason for abandonment of well or producing formation Dry Hole

If a producing well is abandoned, date of last production 19

Was permission obtained from the Conservation Division or its agents before plugging was commenced? Yes

Name of Conservation Agent who supervised plugging of this well Duane L. Rankin  
Producing formation \_\_\_\_\_ Depth to top \_\_\_\_\_ Bottom \_\_\_\_\_ Total Depth of Well 3990'  
Show depth and thickness of all water, oil and gas formations.

OIL, GAS OR WATER RECORDS

CASING RECORD

FORMATION	CONTENT	FROM	TO	SIZE	PUT IN	PULLED OUT
		0'	717'	8-5/8"	710.20'	None

Describe in detail the manner in which the well was plugged, indicating where the mud fluid was placed and the method or methods used in introducing it into the hold. If cement or other plugs were used, state the character of same and depth placed, from \_\_\_\_\_ feet to \_\_\_\_\_ feet for each plug set.

Plugged with 50 sacks cement at 720';  
10 sacks cement at 40'; and 10 sacks cement  
in rat hole. 11-18-80

(If additional description is necessary, use BACK of this sheet)


Name of Plugging Contractor Allied Cementing Co.

STATE OF KANSAS COUNTY OF SEDGWICK, ss.  
John D. Knightley (employee of owner) or (owner or operator)  
of the above-described well, being first duly sworn on oath, says: That I have knowledge of the facts, statements, and matters herein contained and the log of the above-described well as filed and that the same are true and correct. So help me God.

(Signature) [Signature]  
221 S. Broadway, Suite 400, Wichita, KS 67202  
(Address)

SUBSCRIBED AND SWORN TO before me this 17th day of November, 19 80

[Signature]  
Notary Public.  
My commission expires March 12, 1983

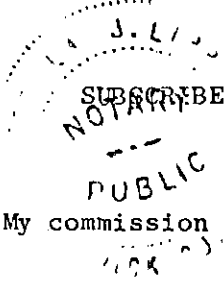

D. R. Lauck Oil Company, Inc. - Wurm #1  
 221 S. Broadway, Suite 400 NW SE NE Sec. 2-22S-16W  
 Wichita, Kansas 67202 Pawnee County, Kansas

Contractor: D. R. Lauck Oil Company, Inc.  
 221 S. Broadway, Suite 400  
 Wichita, Kansas 67202

Commenced: October 10, 1980  
 Completed: October 18, 1980

Drillers Log

Sand	128
Blue Shale	550
Shale	720
Red Bed	978
Anhydrite	1002
Red Bed	1175
Red Bed & Shale	1851
Shale & Shells	2840
Shale & Lime	3300
Shale & Shells	3520
Shale & Lime	3583
Lime & Shale	3880
Lime	3915
Lime & Shale	3935
Lime	3990 RTD

RECEIVED  
 OCT 21 1980

OCT 19 1980

CONSERVATION DIVISION  
 Wichita, Kansas