

WELL PLUGGING RECORD

Give All Information Completely
Make Required Affidavit
Mail or Del. Report to:
Conservation Division
State Corporation Commission
800 Bittling Building
Wichita, Kansas

Pawnee County. Sec. 2 Twp. 22 Rge. 16 (E) 16 (W)

Location as "NE/CNW $\frac{1}{4}$ SW $\frac{1}{4}$ " or footage from lines NE NE SE

Lease Owner Iron Drilling Co.

Lease Name Shady "B" Well No. 1

Office Address 1206 Philtower Bldg., Tulsa, Okla.

Character of Well (completed as Oil, Gas or Dry Hole) Dry Hole

Date well completed 6/7/52 19

Application for plugging filed 6/7/52 19

Application for plugging approved 6/7/52 19


Plugging commenced 6/7/52 19

Plugging completed 6/7/52 19

Reason for abandonment of well or producing formation Dry Hole

If a producing well is abandoned, date of last production None 19

Was permission obtained from the Conservation Division or its agents before plugging was commenced? Yes

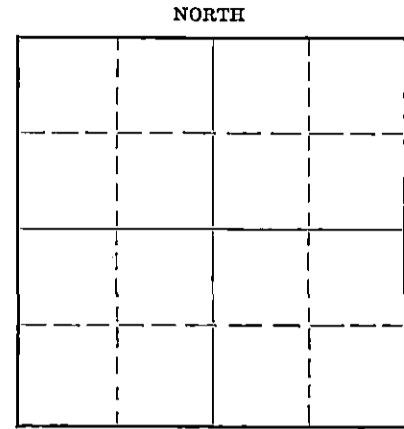

Locate well correctly on above Section Plat

Name of Conservation Agent who supervised plugging of this well M. A. Rives

Producing formation _____ Depth to top _____ Bottom _____ Total Depth of Well 3986 Feet

Show depth and thickness of all water, oil and gas formations.

OIL, GAS OR WATER RECORDS

CASING RECORD

Formation	Content	From	To	Size	Put In	Pulled Out
				8-5/8	704	None


Describe in detail the manner in which the well was plugged, indicating where the mud fluid was placed and the method or methods used in introducing it into the hole. If cement or other plugs were used, state the character of same and depth placed, from _____ feet to _____ feet for each plug set.

Hole filled with heavy Mud through Drill Pipe

20 sacks cement Plug set @ 270 feet

10 sacks cement Plug set @ 35 feet

6-17-52

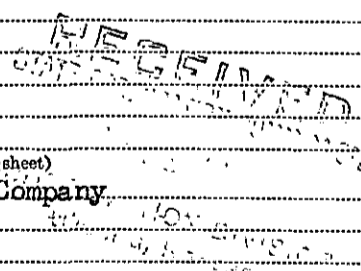

(If additional description is necessary, use BACK of this sheet)

Correspondence regarding this well should be addressed to Iron Drilling Company

Address 1206 Philtower Bldg., Tulsa, Oklahoma

STATE OF Oklahoma, COUNTY OF Tulsa, ss.

J. L. Stackpole (employee of owner Iron Drilling Company) of the above-described well,

being first duly sworn on oath, says: That I have knowledge of the facts, statements, and matters herein contained and the log of the above-described well as filed and that the same are true and correct. So help me God.

(Signature) J. L. Stackpole

(Address)

SUBSCRIBED AND SWORN to before me this 16th day of June, 19 52.

B. Michal

Notary Public.

My commission expires Feb. 28, 1956

PLUGGING
FILE SEC 2 T 24 N 16 W
COR PAGE 2 LINE 19

DRILLING RECORD

15-145-00014-0000

Well Shady "B" No. 1
Located NE NE SE
Sec. 2-22-16W, Pawnee County, Kans.

Casing Record

704' of 8-5/8" OD Surface
Pipe cemented with 450 sacks.

No Oil String - Dry Hole

Work Commenced 5/22/52
Drilling Commenced 5/23/52
Drilling completed 6/7/52
Work Completed 6/7/52

Well Log

Sand, Shale & Shells	0 to 420
Sand	420 to 555
Red Bed	555 to 980
Anhydrite	980 to 1010
Shale & Shells	1010 to 1550
Shale & Salt	1550 to 1590
Shale & Shells	1590 to 1800
Shale & Salt & Lime	1800 to 1890
Shale & Lime	1890 to 3353
Lime	3353 to 3397
Shale & Lime	3397 to 3519
Lime	3519 to 3883
Conglomerate	3883 to 3914
Shale	3914 to 3925
Lime	3925 to 3986 TD

PLUGGING
 FILE SEC 2 T 24 R 16
 BOOK PAGE 24 LINE 19

MIN DIVISION
Kansas