


STATE OF KANSAS  
STATE CORPORATION COMMISSION

Give All Information Completely  
Make Required Affidavit  
Mail or Deliver Report to:  
Conservation Division  
State Corporation Commission  
211 North Broadway  
Wichita, Kansas

15-145-01399-0000  
WELL PLUGGING RECORD

Pawnee County, Sec. 26 Twp. 22 Rge. 16W (E) 2 (W)

Location as "NE/CNW/SW" or footage from lines NE-NW-NE  
Lease Owner Great Bend Pipe & Supply  
Lease Name Shady "A" Well No. 2  
Office Address Great Bend, Kansas  
Character of Well (completed as Oil, Gas or Dry Hole) Oil  
Date well completed \_\_\_\_\_ 19\_\_\_\_  
Application for plugging filed \_\_\_\_\_ 19\_\_\_\_  
Application for plugging approved \_\_\_\_\_ 19\_\_\_\_  
Plugging commenced 8-12 1960  
Plugging completed 8-15 1960  
Reason for abandonment of well or producing formation \_\_\_\_\_

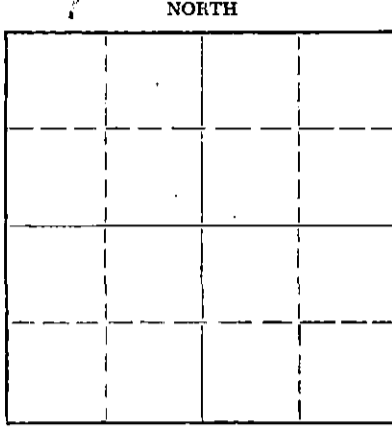

Locate well correctly on above Section Plat

If a producing well is abandoned, date of last production \_\_\_\_\_ 19\_\_\_\_  
Was permission obtained from the Conservation Division or its agents before plugging was commenced? yes

Name of Conservation Agent who supervised plugging of this well Frank Broadfoot  
Producing formation \_\_\_\_\_ Depth to top \_\_\_\_\_ Bottom \_\_\_\_\_ Total Depth of Well 3933 Feet  
Show depth and thickness of all water, oil and gas formations.

OIL, GAS OR WATER RECORDS

CASING RECORD

FORMATION	CONTENT	FROM	TO	SIZE	PUT IN	PULLED OUT
				8 5/8	862	none
				5 1/2	3932	3006

Describe in detail the manner in which the well was plugged, indicating where the mud fluid was placed and the method or methods used in introducing it into the hole. If cement or other plugs were used, state the character of same and depth placed, from \_\_\_\_\_ feet to \_\_\_\_\_ feet for each plug set.

Produced from 2936 to 3001 - dumped 5 sks cement - called Globe Cementing Co. pumped in one load of cement.

9-27-60

STATE CORPORATION COMMISSION  
SEP 27 1960  
CONSERVATION DIVISION  
Wichita, Kansas

(If additional description is necessary, use BACK of this sheet)  
Name of Plugging Contractor R & D Casing Pulling Co. License #236  
Address Box 154, Ellinwood, Kansas

STATE OF Kansas, COUNTY OF Barton, ss. Nathan Meltzer  
(employee of owner) or (owner or operator) of the above-described well, being first duly sworn on oath, says: That I have knowledge of the facts, statements, and matters herein contained and the log of the above-described well as filed and that the same are true and correct. So help me God.

(Signature) Nathan Meltzer  
Box 191, Great Bend, Kansas  
(Address)

SUBSCRIBED AND SWORN TO before me this 26th day of September, 1960

My commission expires 3/30/61  
Anne Meltzer Notary Public.



DRILLING RECORD

Well No. 2 Shady "A"  
Located NE NW NE Sec. 2-22S-16W  
Pawnee County, Kansas

Casing Record

862' of 8-5/8" Surface pipe  
cemented with 400 sacks.

Work commenced 3/9/54  
Drilling commenced 3/9/54  
Drilling completed 3/24/54  
Work completed 3/26/54

3932' of 5 1/2" OD casing cemented  
with 125 sacks.

WELL LOG

Sand	0 to 70
Blue Shale	70 to 355
Red Bed	355 to 410
Sand	410 to 500
Red Bed	500 to 862
Red Bed & Red Rock	862 to 963
Anhydrite	963 to 988
Shale	988 to 1080
Shale & Shells	1080 to 1857
Shale & Lime	1857 to 2164
Lime & Sand	2164 to 2290
Lime & Shale	2290 to 2650
Shale	2650 to 2935
Shale & Lime	2935 to 3245
Lime	3245 to 3368
Lime & Shale	3368 to 3500
Lime	3500 to 3760
Lime & Shale	3760 to 3818
Conglomerate	3818 to 3871
Simpson	3871 to 3920
Arbuckle	→ 3920 to 3933 TD

Perforations:

25 holes - 3926' - to 3923  
60 ' - 3828 to 3818

STATE COMMISSION  
AUG 8 1960  
CONSERVATION DIVISION  
Wichita, Kansas