


STATE OF KANSAS
STATE CORPORATION COMMISSION

Give All Information Completely
Make Required Affidavit
Mail or Deliver Report to:
Conservation Division
State Corporation Commission
800 Bittling Bldg.
Wichita, Kansas

WELL PLUGGING RECORD

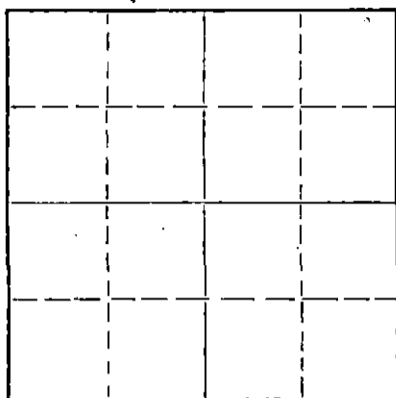

Locate well correctly on above
Section Plat

Pawnee County, Sec. 26 Twp. 22S Rge. 16W (E) W (W)
Location as "NE/CNW/SW" or footage from lines NE NE NE
Lease Owner Fred B. Anschutz d/b/a Anschutz Drilling Co.
Lease Name Barstow Well No. 1
Office Address 709 Union National Bank Bldg.
Character of Well (completed as Oil, Gas or Dry Hole) Dry Hole
Date well completed May 15, 19 55
Application for plugging filed May 15, 19 55
Application for plugging approved May 15, 19 55
Plugging commenced May 15, 19 55
Plugging completed May 15, 19 55
Reason for abandonment of well or producing formation Dry Hole

If a producing well is abandoned, date of last production _____ 19 ____
Was permission obtained from the Conservation Division or its agents before plugging was commenced? Yes

Name of Conservation Agent who supervised plugging of this well M. A. Rives - Pratt, Kansas
Producing formation _____ Depth to top _____ Bottom _____ Total Depth of Well 4095 Feet
Show depth and thickness of all water, oil and gas formations.

OIL, GAS OR WATER RECORDS

CASING RECORD

FORMATION	CONTENT	FROM	TO	SIZE	PUT IN	PULLED OUT
				8 5/8"	253'	None

Describe in detail the manner in which the well was plugged, indicating where the mud fluid was placed and the method or methods used in introducing it into the hole. If cement or other plugs were used, state the character of same and depth placed, from _____ feet to _____ feet for each plug set.

Pumped 140 sacks cement through swedgw by Sun Cementing Co.

RECEIVED
STATE CORPORATION COMMISSION
MAY 19 1955
CONSERVATION DIVISION
Wichita, Kansas
5-18-55

(If additional description is necessary, use BACK of this sheet)
Name of Plugging Contractor Anschutz Drilling Co., Inc.
Address 709 Union National Bank Building

STATE OF Kansas, COUNTY OF Sedgwick, ss.
E. G. Koelling (employee of owner) or (owner or operator) of the above-described well, being first duly sworn on oath, says: That I have knowledge of the facts, statements, and matters herein contained and the log of the above-described well as filed and that the same are true and correct. So help me God.

(Signature) E. G. Koelling
Vice-President
709 Union National Bank Bldg.
(Address)

SUBSCRIBED AND SWORN to before me this 17th day of May, 19 55

Charlene Barbour
Notary Public.

My commission expires July 28, 1958.

PLUGGING
FILE SEC 26 T 22 S R 16 W
BOOK PAGE 119 LINE 8

D R I L L E R ' S L O G

Fred B. Anschutz
 #1 Barstow
 NE NE NE 26-22S-16W
 Pawnee County, Kansas

<u>TO</u>	<u>FROM</u>	
0	150	Sand
150	255	Shale
255	440	Shale & Red Bed
440	600	Sand
600	925	Sandy Shale
925	974	Shale & Shells
974	998	Anhydrite
998	1930	Shale & Shells
1930	2675	Lime & Shale
2675	2815	Shale & Lime
2815	3020	Lime & Shale
3020	3160	Shale & Lime
3160	3731	Lime & Shale
3731	3840	Lime
3840	3949	Lime & Shale
3949	4037	Conglomerate
4037	4067	Simpson Shale
4067	4095	Arbuckle
	4095	ROTARY TOTAL DEPTH

COMMENCED: 5-3-55
 COMPLETED: 5-15-55

CASING RECORD:

Set 2531 of 8 5/8" surface casing
 with 175 sacks cement

D & A

STATE OF KANSAS)
) SS
 COUNTY OF SEDGWICK)

I hereby affirm that the above and foregoing is a true and correct copy of the log of the #1 Barstow located NE NE NE of Section 26-22S-16W, Pawnee County, Kansas.

ANSCHUTZ DRILLING CO., INC.

RECEIVED
 STATE CORPORATION COMMISSION
 MAY 18 1955
 CONSERVATION DIVISION
 Wichita, Kansas

BY:

E. G. Koelling
 E. G. Koelling
 Vice-President

Subscribed and sworn to before me this 17th day of May, 1955.

Charlene Barkow
 Notary Public

My Commission Expires: July 28, 1958.

PLUGGING
 FILE NO. 26-22S-16W
 PAGE 119 LINE 8