

STATE OF KANSAS
STATE CORPORATION COMMISSION

Form CP-4


WELL PLUGGING RECORD

Give All Information Completely
Make Required Affidavit
Mail or Deliver Report to:
Conservation Division
State Corporation Commission
211 No. Broadway
Wichita, Kansas

Pawnee County. Sec. 31 Twp. 22S Rge. (E) 16 (W)
Location as "NE/CNW&SW4" or footage from lines C SW NE

Lease Owner Braden Drilling, Inc.
Lease Name Pike Well No. 1
Office Address 1620 Wichita Plaza, Wichita, Kansas
Character of Well (completed as Oil, Gas or Dry Hole) Dry
Date well completed June 3, 19 65
Application for plugging filed June 3, 19 65
Application for plugging approved June 3, 19 65
Plugging commenced June 3, 19 65
Plugging completed June 3, 19 65
Reason for abandonment of well or producing formation Dry

NORTH

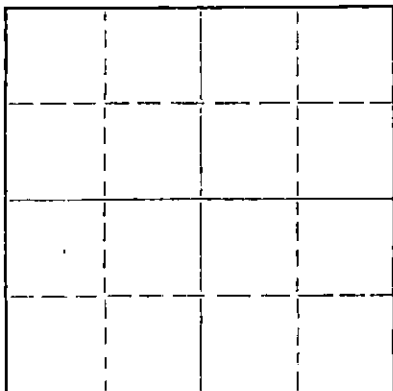

Locate well correctly on above
Section Plat

If a producing well is abandoned, date of last production _____ 19____
Was permission obtained from the Conservation Division or its agents before plugging was com-
menced? Yes

Name of Conservation Agent who supervised plugging of this well Eldon Petty
Producing formation _____ Depth to top _____ Bottom _____ Total Depth of Well 4205 Feet
Show depth and thickness of all water, oil and gas formations.

OIL, GAS OR WATER RECORDS

CASING RECORD

FORMATION	CONTENT	FRDM	TD	SIZE	PUT IN	PULLED OUT
		0	248	8 5/8	248	none

Describe in detail the manner in which the well was plugged, indicating where the mud fluid was placed and the method or methods used in introducing it into the hole. If cement or other plugs were used, state the character of same and depth placed, from _____ feet to _____ feet for each plug set.

First plug at 420' with 20 sacks cement.
Middle plug at 240' with 20 sacks cement.
Third plug at 40' with 1/3 sack of hulls
and 10 sacks cement.

RECEIVED
STATE CORPORATION COMMISSION

JUN 11 1965

CONSERVATION DIVISION
Wichita, Kansas

6-11-65

(If additional description is necessary, use BACK of this sheet)

Name of Plugging Contractor Braden Drilling, Inc.
Address 1620 Wichita Plaza, Wichita, Kansas

STATE OF Kansas COUNTY OF Sedgwick, ss.
James Tasheff (employee of owner) or (owner or operator) of the above-described well, being first duly sworn on oath, says: That I have knowledge of the facts, statements, and matters herein contained and the log of the above-described well as filed and that the same are true and correct. So help me God.

(Signature) James Tasheff

(Address)

SUBSCRIBED AND SWORN TO before me this 9th day of June, 1965

My commission expires March 21, 1966

Helen Schultz
Notary Public.

DRILLER'S LOG

Braden Drilling, Inc.
 Pike #1
 C SW NE Sec. 31-22S-16W
 Pawnee County, Kansas

Commenced: May 26, 1965

Completed: June 3, 1965

Set 8-5/8" surface casing at 248'
 and cemented with 225 sacks cement.

<u>Formation</u>	<u>From</u>	<u>To</u>
Sand and Surface clay	0	248
Shale and Redbed	248	525
Redbed	525	527
Sand	527	619
Redbed, Shale and Shells	619	1083
Anhydrite	1083	1104
Shale and Shells	1104	1300
Shale	1300	1840
Shale and Shells	1840	1888
Shale and Lime	1888	2025
Shale and Lime	2025	2178
Lime	2178	2310
Lime and Shale	2310	2420
Lime and Shale	2420	2583
Shale and Lime	2583	2735
Shale and Lime streaks	2735	2840
Lime and Shale	2840	3115
Shale and Lime	3115	3265
Lime	3265	3360
Lime	3360	3473
Lime	3473	3560
Lime	3560	3730
Lime	3730	3827
Lime	3827	3900
Lime	3900	3995
Lime	3995	4083
Lime	4083	4122
Lime, Shale and Chert	4122	4126
Lime	4126	4150
Lime	4150	4205 T.D.


RECEIVED
 STATE CORPORATION COMMISSION
 JUN 11 1965
 CONSERVATION DIVISION
 Wichita, Kansas

I hereby certify that this is a true and correct log of the above captioned well as shown by the daily drilling reports.


 James Tasheff

Subscribed and sworn to before me this 9th day of June, 1965.

My commission expires March 21, 1966


 Helen Schultz, Notary Public