

STATE OF KANSAS
STATE CORPORATION COMMISSION
Give All Information Completely
Make Required Affidavit
Mail or Deliver Report to:
Conservation Division
State Corporation Commission
212 North Market, Insurance Bldg.
Wichita, Kansas

WELL PLUGGING RECORD

PAWNEE County, Sec. 1 Twp. 22 Rge. 16W (E) (W)

Location as "NE/CNW/SW" or footage from lines SE NW NW

Lease Owner SANTA FE PIPE & SUPPLY

Lease Name MALIN # Well No. 1

Office Address P. O. BOX 562, GREAT BEND, KANSAS

Character of Well (completed as Oil, Gas or Dry Hole) Gas

Date well completed JANUARY 3 1952

Application for plugging filed 19

Application for plugging approved MARCH 24, 1961

Plugging commenced MARCH 25 1961

Plugging completed APRIL 1, 1961

Reason for abandonment of well or producing formation DEPLETED

If a producing well is abandoned, date of last production 19

Was permission obtained from the Conservation Division or its agents before plugging was commenced? YES

Name of Conservation Agent who supervised plugging of this well FRANK BROADFOOT

Producing formation Depth to top Bottom Total Depth of Well 3969 Feet

Show depth and thickness of all water, oil and gas formations.

OIL, GAS OR WATER RECORDS

CASING RECORD

FORMATION	CONTENT	FROM	TO	SIZE	PUT IN	PULLED OUT
				8 5/8	690'	NONE
				5 1/2"	3969	3220'

Describe in detail the manner in which the well was plugged, indicating where the mud fluid was placed and the method or methods used in introducing it into the hole. If cement or other plugs were used, state the character of same and depth placed, from feet to feet for each plug set.

3964' - 3950' - FILLED WITH SAND
 3950' - 3920' - 5 SACKS CEMENT
 3920' - 300' - MUD
 300' - 290' - ROCK BRIDGE
 290' - 230' - 20 SACKS CEMENT
 230' - 35' - MUD
 35' - BASE - ROCK & 10 SACKS CEMENT

RECEIVED
STATE CORPORATION COMMISSION

JUN 15 1961

CONSERVATION DIVISION
Wichita, Kansas

6-15-1961

(If additional description is necessary, use BACK of this sheet)

Name of Plugging Contractor GLENN & SMITH PIPE PULLING COMPANY

Address P. O. BOX 114, ELLINWOOD, KANSAS

STATE OF KANSAS, COUNTY OF BARTON, ss. T. L. NUTT

(employee of owner) or (owner or operator) of the above-described well, being first duly sworn on oath, says: That I have knowledge of the facts, statements, and matters herein contained and the log of the above-described well as filed and that the same are true and correct. So help me God.

(Signature) [Signature]

(Address) -

SUBSCRIBED AND SWORN to before me this 9 day of JUNE, 1961

My commission expires FEB 25, 1963


[Signature] Notary Public.



Company- IRON DRILLING CO.
Farm- T. A. Malin No. 1

SEC. 11 T. 22 R. 16W
SE NW NW

Total Depth. 3969
Comm. 1-3-52 Comp. 1-18-52
Shot or Treated.
Contractor.
Issued. 3-1-52

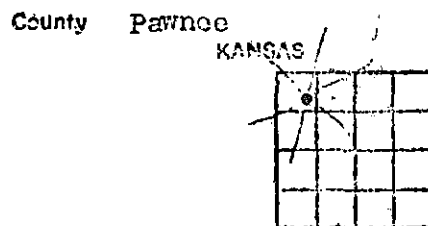

CASING:
8 5/8" 690' cem. w/350 sx
5 1/2" 3969' cem. w/100 sx

Elevation. 2007

Production. 1,800,000 Gas

Figures Indicate Bottom of Formations.

sand	140
shale & sand	255
shale & shells	415
sand	525
red bed	690
shale	715
red bed	795
anhydrite	830
red shale	970
lime & shale	1260
shale & shells	1360
salt & shale	1550
shale	1555
shale & shells	1765
shale & lime	1865
lime	2020
sand & lime	2045
shale & lime	2145
sandy lime	2195
lime	2505
shale & lime	2935
shale	2995
shale & lime	3033
lime	3230
lime & shale	3320
lime	3410
lime & shale	3424
lime	3445
lime & shale	3493
lime	3884
shale & lime	3893
lime	3925
lime & shale	3962
chert & lime	3969
Total Depth	

Scout Tops:

Topeka	2074 ?
Heebner	3419
Brown Lime	3524
Lansing	3532
Simpson	3903
Arbuckle	3956

RECEIVED
STATE CORPORATION COMMISSION

JUN 15 1961

CONSERVATION DIVISION
Wichita, Kansas