


STATE OF KANSAS
STATE CORPORATION COMMISSION

Give All Information Completely
Make Required Affidavit
Mail or Deliver Report to:
Conservation Division
State Corporation Commission
800 Bittling Building
Wichita, Kansas

WELL PLUGGING RECORD

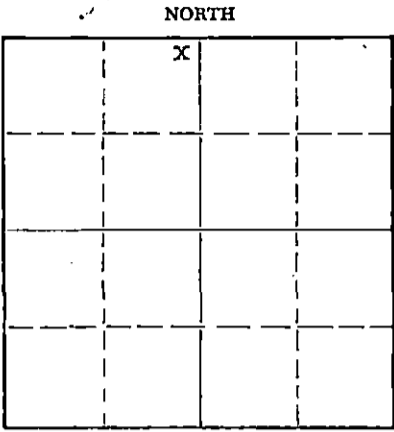

Pawnee County. Sec. 23 Twp. 22 Rge. 15 (X)W (W)
Location as "NE/CNW/SW" or footage from lines C NE/4 NE/4 NW/4
Lease Owner Transit Corporation
Lease Name Hirsch Well No. 1
Office Address 1516 Liberty Bank Bldg., Okla. City, Okla.
Character of Well (completed as Oil, Gas or Dry Hole) Dry hole
Date well completed 5-14- 1955
Application for plugging filed 5-14 1955
Application for plugging approved 5-14 1955
Plugging commenced 5-14 1955
Plugging completed 5-14 1955
Reason for abandonment of well or producing formation _____

If a producing well is abandoned, date of last production _____ 19____
Was permission obtained from the Conservation Division or its agents before plugging was commenced? Yes

Name of Conservation Agent who supervised plugging of this well Warren H. Horner, Great Bend, Kansas.
Producing formation _____ Depth to top _____ Bottom _____ Total Depth of Well 4023 Feet
Show depth and thickness of all water, oil and gas formations.

OIL, GAS OR WATER RECORDS

CASING RECORD

FORMATION	CONTENT	FROM	TO	SIZE	PUT IN	PULLED OUT
				8-5/8"	225	None

Describe in detail the manner in which the well was plugged, indicating where the mud fluid was placed and the method or methods used in introducing it into the hole. If cement or other plugs were used, state the character of same and depth placed, from _____ feet to _____ feet for each plug set.

Welded collar in cellar, filled hole to 225 feet with heavy drilling mud, set plug and cemented to bottom of cellar with 100 sacks cement. Pressure of 200#.

5-20-55

MISSILE
MAY 2 1955
CONSERVATION DIVISION
WICHITA, KANSAS

(If additional description is necessary, use BACK of this sheet)

Name of Plugging Contractor Transit Corporation
Address 1516 Liberty Bank Bldg., Oklahoma City, Okla.

STATE OF Oklahoma, COUNTY OF Oklahoma, ss.
C. W. Dodson (employee of owner) or (owner or operator) of the above-described well, being first duly sworn on oath, says: That I have knowledge of the facts, statements, and matters herein contained and the log of the above-described well as filed and that the same are true and correct. So help me God.

(Signature) C. W. Dodson
Oklahoma City, Okla (Address)

SUBSCRIBED AND SWORN to before me this 19th day of May, 19 55

J. A. Brady Notary Public.

My commission expires January 28, 1955

PLUGGING
FILE SEC 23 Twp 22 R 15W
BOOK PAGE 119 LINE 9

TRANSIT CORPORATION
Oklahoma City, Oklahoma.
Driller's Log
Hirsch #1

NE NE NW Sec. 23-22-15W
Pawnee County, Kans.

Elevation: 1976'

<u>Formation</u>	<u>From</u>	<u>To</u>	Commenced: 5-1-55	Completed: 5-14-55
Sand	0	75		
Shale & Shells	75	218	8-5/8" csg. @ 218' cemented w/ 200 sacks cement.	
Shale & Shells	218	750		
Red Bed	750	925		
Anhydrite	925	955		
Red Bed and Shale	955	1185		
Red Bed	1185	1405		
Shale & Shells	1405	1760		
Sandy Lime	1760	1830		
Broken Lime	1830	1950		
Lime	1950	2080		
Sandy Lime & Shale	2080	2505		
Shale & Shells	2505	2829		
Lime & Shale	2829	3135		
Lime	3135	3205		
Lime & Shale	3205	3539		
Lime	3539	3730		
Broken Lime	3730	3780		
Lime & Shale	3780	3869	Top Anhydrite	925
Conglomerate	3869	3871	Top Conglomerate	3869
Viola	3871	3885	Top Viola	3871
Lime	3885	3914	Top Arbuckle	3995
Cherty Lime	3914	3945	Rotary Total Depth	4023
Shale & Sand	3945	3995		
Lime, Arbuckle	3995	4023		
Total Depth		4023		

FORMATION TOPS

I hereby certify the foregoing to be a true and accurate Driller's Log of the formations encountered in the above well.

TRANSIT CORPORATION

BY: C. W. Dodson
 C. W. Dodson

Subscribed and sworn to before me this the 20th day of May, 1955.

Jane A. Brady
 Notary Public

My comm. exp. Jan. 28, 1959.

PLUGGING
 REC. SEC 23 T 22 S 15 W
 PAGE 119 LINE 9

RECEIVED
 STATE CORPORATION COMMISSION

MAY 20 1955
 CONSERVATION DIVISION
 Wichita, Kans.