


WELL PLUGGING RECORD

Give All Information Completely  
Make Required Affidavit  
Mail or Deliver Report to:  
Conservation Division  
State Corporation Commission  
800 Bittling Building  
Wichita, Kansas

NORTH

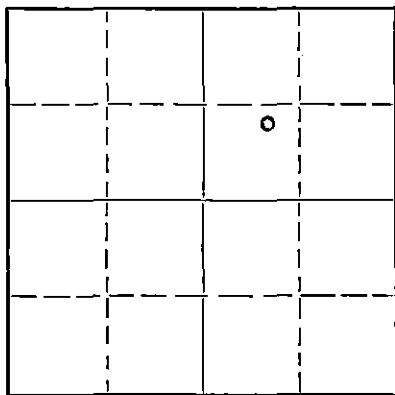

Locate well correctly on above  
Section Plat

Pawnee County. Sec. 21 Twp. 23S Rge. (E) 15 (W)  
Location as "NE/CNW $\frac{1}{4}$ SW $\frac{1}{4}$ " or footage from lines NE $\frac{1}{4}$  SW $\frac{1}{4}$  NE $\frac{1}{4}$   
Lease Owner Stanolind Oil and Gas Company  
Lease Name Myrtle N. Fair Well No. 1  
Office Address Box 7, Ellinwood, Kansas  
Character of Well (completed as Oil, Gas or Dry Hole) dry hole  
Date well completed 12-10-1950  
Application for plugging filed 12-12-1950  
Application for plugging approved 12-12-1950  
Plugging commenced 12-10-1950  
Plugging completed 12-10-1950  
Reason for abandonment of well or producing formation dry hole

If a producing well is abandoned, date of last production 19  
Was permission obtained from the Conservation Division or its agents before plugging was commenced? yes

Name of Conservation Agent who supervised plugging of this well C. D. Stough  
Producing formation none Depth to top Bottom Total Depth of Well 4068 Feet  
Show depth and thickness of all water, oil and gas formations.

OIL, GAS OR WATER RECORDS

CASING RECORD

Formation	Content	From	To	Size	Put In	Pulled Out
Lansing K.C.	None	3543	3990	8-5/8"	960	none
Simpson	None	3990	4026			
Arbuckle	Water	4026	4068			

Describe in detail the manner in which the well was plugged, indicating where the mud fluid was placed and the method or methods used in introducing it into the hole. If cement or other plugs were used, state the character of same and depth placed, from feet to feet for each plug set.  
Td - 4068 heavy mud to 300', wood plug, 20 sx cement, heavy mud to 30', wood plug, 10 sx cement to floor of cellar.

3-22-51

RECEIVED  
STATE CORPORATION COMMISSION  
MAR 22 1951  
C. D. STOUGH, EMISIAN  
Wichita, Kansas

(If additional description is necessary, use BACK of this sheet)  
Correspondence regarding this well should be addressed to G. A. Younie  
Address Box 7, Ellinwood, Kansas

STATE OF Kansas, COUNTY OF Barton, ss.  
G. A. Younie (employee of owner) or (owner or operator) of the above-described well,  
being first duly sworn on oath, says: That I have knowledge of the facts, statements, and matters herein contained and the log of the above-described well as filed and that the same are true and correct. So help me God.

(Signature) *G. A. Younie*  
Box 7, Ellinwood, Kansas  
(Address)

SUBSCRIBED AND SWORN TO before me this 20th day of March, 1951

*D. J. H. Rader*  
Notary Public.

My commission expires November 14, 1953

PLUGGING  
FILE SEC 21 T 23 R 15 W  
BOOK PAGE 48 LINE 22

FORMATION RECORD

DESCRIBE EACH FORMATION DRILLED. INDICATE THICKNESS, CONTENT AND WHETHER DRY, OR OIL, GAS, OR WATER BEARING.

FORMATION	TOP	BOTTOM	FORMATION	TOP	BOTTOM
Shale bed	0	400			
Red shale	400	704			
Shale	704	715			
Shale	715	810			
Anhydrite	810	1430			
Broken lime and shale	1430	1850			
Lime	1850	1995			
Lime and shale	1995	2060			
Lime	2060	3460			
Shale and lime	3460	3543			
Top Lansing		3543			
Lime	3532	3638			
Top Simpson		3990			
Lime and shale	3990	4026			
Top Arbuckle		4026			
Lime	4026	4086			
Top Lansing		3543			
Top Simpson		3990			
Top Arbuckle		4026			
<u>Total Depth</u>					
By Schlumberger		4068			
By Rotary Drill		4068			
D.S.T.	4039	4068			
Tool open 1 hr. Rec 3438'					
Arbuckle water BHP 1350					
Completed as a dry hole					
12-10-50					
D.F.W. 11-9-50					
Spudded 11-11-50					
Completed 12-10-50					

**PLUGGING**  
 FILE SEC-21-1-11-182  
 BOOK PAGE 48 LINE 28

STANOLIND OIL AND GAS COMPANY

WELL RECORD

TWP. 22 S N OR S

SUPPLEMENTAL (ENTER "X" WHEN APPLICABLE)

Grid for well location with '21' and '15' marked in the 2nd and 3rd columns from the right.

LEASE Myrtle N. Fair WELL NO. 1

LOCATION OF WELL: 1650 FT. NORTH SOUTH OF THE 1650 FT. NORTH SOUTH LINE AND

EAST WEST OF THE EAST WEST LINE OF THE 1/4 1/4 1/4

OF SECTION 21 TOWNSHIP 22 NORTH SOUTH. RANGE 15 EAST WEST.

Pawnee COUNTY Kansas STATE

ELEVATION: 1999'

COMPLETED AS: OIL WELL GAS WELL WATER WELL DRY HOLE

DRILLING: COMMENCED Nov. 9, 1950 COMPLETED 12-10-1950

LOCATE WELL CORRECTLY

OPERATING COMPANY Stanolind Oil and Gas Company ADDRESS Box 591, Tulsa, Oklahoma

OIL OR GAS SANDS OR ZONES

Table with columns: NAME, FROM, TO, NAME, FROM, TO. Rows include Lansing (3543-3990), Simpson (3990-4026), and Arbuckle (4026-4068).

WATER SANDS

Table with columns: NAME, FROM, TO, WATER LEVEL, NAME, FROM, TO, WATER LEVEL. Rows 1 and 2 are empty.

CASING RECORD (OVERALL MEASUREMENT)

LINER SCREEN RECORD

Tables for casing and liner screen records. Casing record includes 8-5/8 size casing, 22# weight, 8VT threads, SS make, R-40 grade, 961 quantity.

PACKER RECORD

Table for packer record with columns: SIZE, LENGTH, SET AT, MAKE AND TYPE.

CEMENTING RECORD

MUDDING RECORD

Tables for cementing and mudding records. Cementing record includes 8-5/8 size, 961 feet, 500 sacks, Starco brand, Resistant type, Halliburton method, final press.

RECEIVED CORPORATION COMMISSION FEB 9 1951 CONSERVATION DIVISION WICHITA, KANSAS

WHAT METHOD WAS USED TO PROTECT SANDS WHEN OUTER STRINGS WERE PULLED? none pulled

WERE BOTTOM HOLE PLUGS USED?

IF SO, STATE KIND, DEPTH SET, AND RESULTS OBTAINED

ROTARY TOOLS WERE USED FROM FEET TO FEET, AND FROM FEET TO FEET

CABLE TOOLS WERE USED FROM FEET TO FEET, AND FROM FEET TO FEET

24-HOUR PRODUCTION OR POTENTIAL TEST DS Test Zone 4039 - 4068 Tool open 1 hr. rec. Arbuckle water 3438'

BHP 1350

WATER BBLs.

IF GAS WELL, CUBIC FEET PER 24 HOURS SHUT-IN PRESSURE LBS. PER SQUARE IN.

I, THE UNDERSIGNED, BEING FIRST DULY SWORN UPON OATH, STATE THAT THIS WELL RECORD IS TRUE AND CORRECT ACCORDING TO THE RECORDS OF THIS OFFICE AND TO THE BEST OF MY KNOWLEDGE AND BELIEF.

SUBSCRIBED AND SWORN TO BEFORE ME THIS 7th February 1950 OF NAME AND TITLE A. J. H. Reder NOTARY PUBLIC