


STATE OF KANSAS
STATE CORPORATION COMMISSION

WELL PLUGGING RECORD

Give All Information Completely
Make Required Affidavit
Mail or Deliver Report to:
Conservation Division
State Corporation Commission
211 No. Broadway
Wichita, Kansas

Pawnee County. Sec. 31 Twp. 22 Rge. 15 (E) W (W)
Location as "NE/CNW/SW" or footage from lines SE NE SE
Lease Owner El Dorado Refining Company
Lease Name Bowman Well No. 1
Office Address 306 Koch Building, Wichita, Kansas
Character of Well (completed as Oil, Gas or Dry Hole) Dry hole
Date well completed September 15 19 56
Application for plugging filed September 15 19 56
Application for plugging approved September 15 19 56
Plugging commenced September 15 19 56
Plugging completed September 15 19 56
Reason for abandonment of well or producing formation oil in commercial
quantities not found
If a producing well is abandoned, date of last production _____ 19____
Was permission obtained from the Conservation Division or its agents before plugging was com-
menced? yes

NORTH

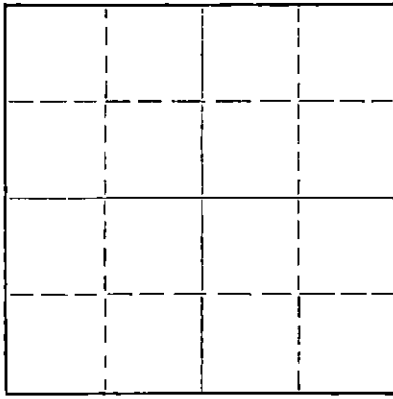

Locate well correctly on above
Section Plat

Name of Conservation Agent who supervised plugging of this well M. A. Rives
Producing formation _____ Depth to top _____ Bottom _____ Total Depth of Well 3980 Feet
Show depth and thickness of all water, oil and gas formations.

OIL, GAS OR WATER RECORDS

CASING RECORD

FORMATION	CONTENT	FROM	TO	SIZE	PUT IN	PULLED OUT
				8-5/8"	341'	none

Describe in detail the manner in which the well was plugged, indicating where the mud fluid was placed and the method or methods used in introducing it into the hole. If cement or other plugs were used, state the character of same and depth placed, from _____ feet to _____ feet for each plug set.

Filled hole with extra heavy rotary mud.
Plugged from 300' to base of cellar with
100 sacks bulk cement.

9-20-56

RECEIVED
STATE CORPORATION COMMISSION

SEP 20 1956

CONSERVATION DIVISION
Wichita, Kansas

(If additional description is necessary, use BACK of this sheet)

Name of Plugging Contractor Prime Drilling Company
Address 814-16 Union Center, Wichita, Kansas

STATE OF KANSAS, COUNTY OF SEDGWICK, ss.
R. R. McNicol (employee of owner) or (owner or operator) of the above-described well, being first duly sworn on oath, says: That I have knowledge of the facts, statements, and matters herein contained and the log of the above-described well as filed and that the same are true and correct. So help me God.

(Signature) R. R. McNicol
814-16 Union Center, Wichita, Kansas
(Address)

SUBSCRIBED AND SWORN to before me this 19th day of September, 19 56

My commission expires September 30, 1959

Darlene May
Notary Public.

PLUGGING
FILE SEC 31 T 22 R 15W
BOOK PAGE 99 LINE 33

ROTARY DRILLING LOG

OPERATOR: El Dorado Refining Company
Bowman No. 1
SE NE SE Sec. 31-22-15W
Pawnee County, Kansas

CONTRACTOR: Prime Drilling Company
COMM: 9/1/56
COMP: 9/15/56

Remarks: Set 8-5/8" surface casing
at 341' cemented with 275 sacks common
cement, 2% C.C.

Formations:

Surface Rock & Clay	20'
Sand	150'
Gray Shale	215'
Shale	342'
Shale & Red Bed	765'
Red Bed Sand Stks	935'
Lime Anhydrite	980'
Shale & Red Bed	1140'
Shale & Shells	1470'
Shale	1595'
Lime & Shale	1960'
Lime	2080'
Shale & Shells	2225'
Shale & Lime	3020'
Lime	3515'
Shale & Lime	3535'
Lime	3845'
Lime & Chert	3890'
Lime	3945'
Shale & Sand	3960'
Shale & Lime	3975'
Arbuckle	3980'
Rotary Total Depth (D&A)	3980'

We certify the above log is true and
correct to the best of our knowledge
and belief.

PRIME DRILLING COMPANY

R. R. McNicol

R. R. McNicol

RECEIVED
STATE CORPORATION COMMISSION
SEP 20 1956
CONSERVATION DIVISION
Wichita, Kansas

PLUGGING
FILE SEC. 31 T. 22 R. 15W
BOOK PAGE 99 LINE 33