


STATE OF KANSAS
STATE CORPORATION COMMISSION

All information completely
State Required State of
Kans. of Public Report to
Conservation Division
State Corporation Commission

P. O. Box 17027
Wichita, Kansas 67217

WELL PLUGGING RECORD

Pawnee County, Sec. 25 Twp. 22 S Rge. 15 W (W)
Location as "NE/CNWSW" or footage from lines SW SE NW
Lease Owner F & M Oil Co., Inc.
Lease Name BARSTOW Well No. #2
Office Address 603 Union Center Building - Wichita, Ks. 67202
Character of Well (completed as Oil, Gas or Dry Hole) Dry Hole
Date well completed June 7, 1974
Application for plugging filed June 7, 1974
Application for plugging approved June 7, 1974
Plugging commenced June 7, 1974
Plugging completed June 7, 1974
Reason for abandonment of well or producing formation

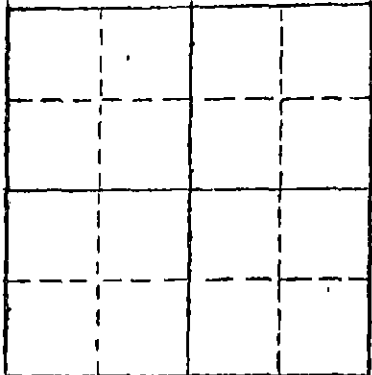

Locate well correctly on above
Section Plat

If a producing well is abandoned, date of last production 10
Was permission obtained from the Conservation Division or its agents before plugging was com-
menced? yes

Name of Conservation Agent who supervised plugging of this well Leo Massey
Producing formation Depth to top Bottom Total Depth of Well 4065 Feet
Show depth and thickness of all water, oil and gas formations.

OIL, GAS OR WATER RECORDS

CASING RECORD

FORMATION	CONTENT	FROM	TO	SIZE	PUT IN	PULLED OUT

Describe in detail the manner in which the well was plugged, indicating where the mud fluid was placed and the method or methods used
in introducing it into the hole. If cement or other plugs were used, state the character of same and depth placed, from feet to
feet for each plug set.

Hole full of heavy mud.
Set bottom plug at 550' with 50 sacks cement thru drill pipe
Top plug set at 40' with 1/2 sack hulls and 10 sacks cement.
2 sacks cement in rat hole.

RECEIVED
STATE CORPORATION COMMISSION

JUN 13 1974

CONSERVATION DIVISION
Wichita, Kansas

Name of Plugging Contractor Duke Drilling Co.
Address Box 823 Great Bend, Kansas 67530

STATE OF Kansas COUNTY OF Barton ss.

Leonard Williamson (employee of owner) or (owner/representative) of the above-described
well, being first duly sworn on oath, says: That I have knowledge of the facts, statements, and matters herein contained and the log of the
above-described well as filed and that the same are true and correct. So help me God.

(Signature) Leonard Williamson

Box 823 - Great Bend, Kansas 67530 (Address)

Subscribed and Sworn to before me this 11th day of June 1974.

My commission expires April 11, 1978

Marathy M. Saguez Notary Public.

DRILLERS' WELL LOG

DATE COMMENCED: May 29, 1974
 DATE COMPLETED: June 7, 1974

F & M Oil Co., Inc.
 BARSTOW #2
 SW SE NW
 Sec. 25-T22S-R15W
 Pawnee County, Kansas

ELEVATION: 1986 K.B.

0 - 155'	Sand & Shale
155 - 375'	Shale
375 - 455'	Sand
455 - 921'	Red Bed
921 - 943'	Anhydrite
943 - 1015'	Red Bed
1015 - 1700'	Shale
1700 - 3426'	Shale & Lime
3426 - 3432'	Shale
3432 - 3454'	Shale & Lime
3454 - 3471'	Lime
3471 - 3553'	Shale
3553 - 3561'	Br. Lime
3561 - 3804'	Lime
3804 - 3913'	Lime Shale & Chert
3913 - 3974'	Shale & Chert
3974 - 4051'	Shale
4051 - 4065'	Dolomite
4065'	RTD

FORMATION DATA

Anhydrite	921
Heebner	3426
Toronto	3454
Douglas	3471
Brown Lime	3553
Kansas City	3561
Base K.C.	3804
Viola	3913
Simpson	3974
Arbuckle	4051

SURFACE PIPE: Set 526' of
 8-5/8" used 24# surface pipe
 with 325 sacks of common cement,
 2% Gel, 3% cc.

AFFIDAVIT

STATE OF KANSAS
 COUNTY OF BARTON) ss.

Leonard Williamson of lawful age, does swear and state that the facts
 and statements herein contained are true and correct to the best of his
 knowledge.

Leonard Williamson

Subscribed and sworn to before me this 10 day of June 1974.

Rosemary M. Hague
 Notary Public

RECEIVED
 STATE CORPORATION COMMISSION
 JUN 13 1974
 CONSERVATION DIVISION
 Wichita, Kansas