


Give All Information Completely  
Make Required Affidavit  
Mail or Deliver Report to:  
Conservation Division  
State Corporation Commission  
800 Bittling Building  
Wichita, Kansas

WELL PLUGGING RECORD

Pawnee County, Sec. 25 Twp. 22S Rge. 15 ~~22X~~ (W)

NORTH

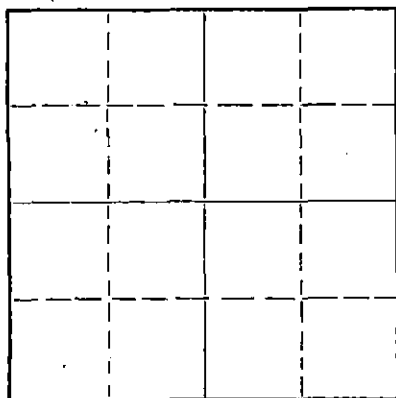

Locate well correctly on above  
Section Plat

Location as "NE/CNW/SE/SW" or footage from lines SW SW NE  
Lease Owner D.R. Lauck Oil Company, Inc.  
Lease Name Ruth E. Barstow Well No. 1  
Office Address 301 South Broadway Wichita 2 Kans  
Character of Well (completed as Oil, Gas or Dry Hole) dry hole  
Date well completed April 28 19 55  
Application for plugging filed April 28 19 55  
Application for plugging approved April 28 19 55  
Plugging commenced April 28 19 55  
Plugging completed April 28 19 55  
Reason for abandonment of well or producing formation dry hole

If a producing well is abandoned, date of last production --- 19 ---  
Was permission obtained from the Conservation Division or its agents before plugging was commenced? yes

Name of Conservation Agent who supervised plugging of this well Warren H. Horner  
Producing formation --- Depth to top --- Bottom --- Total Depth of Well 4107 Feet  
Show depth and thickness of all water, oil and gas formations.

OIL, GAS OR WATER RECORDS

CASING RECORD

FORMATION	CONTENT	FROM	TO	SIZE	PUT IN	PULLED OUT
		0	914	8 5/8	914	none

Describe in detail the manner in which the well was plugged, indicating where the mud fluid was placed and the method or methods used in introducing it into the hole. If cement or other plugs were used, state the character of same and depth placed, from --- feet to --- feet for each plug set.

mud 4107 - 300  
plug 300 - 296  
cement 296 - 256  
mud 256 - 35  
plug 35 - 31  
cement 31 - 6 bottom of cellar

(If additional description is necessary, use BACK of this sheet)

Name of Plugging Contractor Globe Oilwell Cementing Company  
Address Great Bend Kansas

STATE OF Kansas, COUNTY OF Sedgwick, ss.  
John H. Knightley (employee of owner) or (owner or operator) of the above-described well, being first duly sworn on oath, says: That I have knowledge of the facts, statements, and matters herein contained and the log of the above-described well as filed and that the same are true and correct. So help me God.

(Signature)

Wichita Kansas  
(Address)

SUBSCRIBED AND SWORN TO before me this 3rd day of May 19 55

My commission expires Sept. 14, 1955

Elizabeth Ray  
Notary Public.

PLUGGING  
WELL SEC 25 T 22 S R 15 W  
BOOK PAGE 115 LINE 27

RE  
STATE CORP.

MAY 4 1955  
CONSERVATION DIVISION  
Wichita, Kansas

5-4-55

D.R. Lauck Oil Company, Inc.

#1 Ruth E. Barstow

NW SW NE Sec. 25-22S-15W  
Pawnee County Kansas

Commenced: April 14, 1955

Completed: April 28, 1955

Casing Record: 914' 8 5/8" cemented w/450 sacks

Elevation: GR 1979; DP 1981; KB 1983

## Drillers Log

## Tops

		Sample		Schlumberger
Sand, Gravel & Shale	200	Anhydrite	902 p1 1081	
shale	380	Neobner	3427 -1444	3427 -1444
sand	460	Toronto	3445 -1462	3445 -1465
red bed	530	Brown Lime	3551 -1568	3552 -1569
sand	575	Lansing	3560 -1577	3560 -1577
red bed	902	Base K.C.	3796 -1813	3797 -1814
Anhydrite	935	Harrison Chert	3859 -1876	3859 -1876
Shale & shells	1710	Viola	3920 -1937	3917 -1934
shale & Lime	1905	Simpson	3937 -2004	3930 -2007
Lime	2015	Arbuckle	4050 -2067	4050 -2067
Shale & Lime	2745	RTD	4107 -2124	4107 -2124
Shale & Shells	3080			
Lime & shale	3552			
Lime	3870	DST #1	3680-3695	Good blow for 1 hr; Rec. 385' salt water with few specks oil; BHP 1260# in 20 min.
Lime & Conglomerate	3910			
Conglomerate	3930			
Chert	3971			
Lime	3980			
Lime & shale	4030	DST #2	3950-3971	weak blow 8 min; open 30 min. rec. 8' mud with few specks oil BHP 0# in 20 min.
shale	4050			
Arbuckle	4107			

RTD 4107

D &amp; A

I hereby certify that the above is a true and correct copy of the log of the Ruth E. Barstow #1 well, to the best of my knowledge and belief.

Dated at Wichita, Kansas this 3rd day of May 1955.

*John H. Knightley*  
John H. Knightley

Subscribed and sworn to before me this      day of May 1955.

By commission expires: Sept. 14, 1955.

RECEIVED  
STATE CORPORATION COMMISSION  
MAY 4 1955  
CONSERVATION DIVISION  
WICHITA, KANSAS

Notary Public

PLUGGING

FILE SEC 25-22-15W  
BOOK PAGE 115 LINE 27