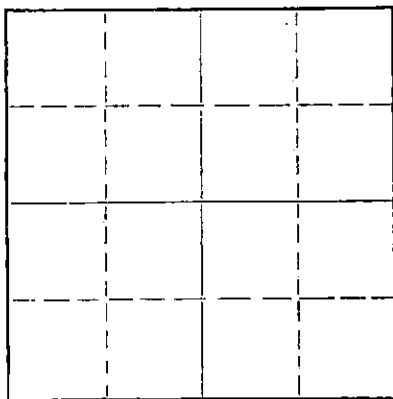


Give All Information Completely
Make Required Affidavit
Mail or Deliver Report to:
Conservation Division
State Corporation Commission
211 No. Broadway
Wichita, Kansas

WELL PLUGGING RECORD 15-155-19264-00-01

NORTH

Locate well correctly on above
Section Plat

Reno County, Sec. 31 Twp. 23 Rge. 10 1/4 (W)
Location as "NE/CNW/SW" or footage from lines s 1/2 of NW of SE 1/4
Lease Owner Messman-Rinehart Oil Co.
Lease Name Ira Johnson Well No. 1
Office Address 518 Petroleum Bldg., Wichita, Kansas
Character of Well (completed as Oil, Gas or Dry Hole) dry hole
Date well completed _____ 19____
Application for plugging filed _____ 19____
Application for plugging approved _____ 19____
Plugging commenced 2-18 19 63
Plugging completed 2-19 19 63
Reason for abandonment of well or producing formation dry hole

If a producing well is abandoned, date of last production _____ 19____
Was permission obtained from the Conservation Division or its agents before plugging was commenced? yes

Name of Conservation Agent who supervised plugging of this well Gilbert J. Toman
Producing formation _____ Depth to top _____ Bottom _____ Total Depth of Well 3704 Feet
Show depth and thickness of all water, oil and gas formations.

OIL, GAS OR WATER RECORDS

CASING RECORD

FORMATION	CONTENT	FROM	TO	SIZE	PUT IN	PULLED OUT
				8 5/8	260'	circulated
				5 1/2	3420	3125.71

Describe in detail the manner in which the well was plugged, indicating where the mud fluid was placed and the method or methods used in introducing it into the hole. If cement or other plugs were used, state the character of same and depth placed, from _____ feet to _____ feet for each plug set.

Well had been sanded back to 3325 feet, dumped 5 sacks cement with bailer. Set 10 foot rock bridge at 260 feet and dumped 20 sacks cement. Mud hole to 40 feet, set 5 foot rock bridge and 10 sacks cement.

RECEIVED
STATE CORPORATION COMMISSION

FEB 28 1963

CONSERVATION DIVISION
Wichita, Kansas

(If additional description is necessary, use BACK of this sheet)
Name of Plugging Contractor Kent Well Servicing Company
Address Box 470, El Dorado, Kansas

STATE OF Kansas, COUNTY OF Butler, ss.

_____, (employee of owner) or (owner or operator) of the above-described well, being first duly sworn on oath, says: That I have knowledge of the facts, statements, and matters herein contained and the log of the above-described well as filed and that the same are true and correct. So help me God.

(Signature) Mary Payne

(Address)

SUBSCRIBED AND SWORN TO before me this 27th day of February, 19 63.My commission expires June 18, 1963E. Helen E. Phillips

Notary Public.

WELL LOG BUREAU — KANSAS GEOLOGICAL SOCIETY
412 Union National Bk. Bldg., Wichita, Kansas


15-155-19264-00-01

Company - STANOLIND OIL & GAS CO.
Farm - Ira C. Johnson No. 4.

SEC. 31 T. 23 R. 10 W
C S $\frac{1}{2}$ NW SE
1650' N SL 660' E WL SE $\frac{1}{2}$

Total Depth. 3804' PB 3740'
Comm. 11-29-43 Comp. 1-13-44
Shot or Treated.
Contractor.
Issued. 3-4-44 Rotary O-3733
Cable 3733-3804

County. Reno
KANSAS

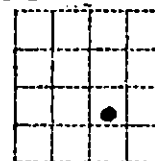

CASING:
8 5/8" 264'9" Cem.
5 1/2" 3729'5" Cem.

Elevation.

Production. Pot. 247 B.

Figures Indicate Bottom of Formations.

cellar	8 $\frac{1}{2}$
surface soil & clay	166
red rock	200
red bed & shells	400
shale & shells	610
anhydrite & shells	660
shale brown & shells	815
shale blue & shells	1040
shale & lime shells	1485
shale & lime	1595
lime brkn	1810
lime sdy sharp	1830
lime brkn	2080
shale	2100
shale & shells	2120
lime brkn & shale	2510
lime brkn	2700
lime	2760
lime & shale	2805
lime brkn	2845
lime	3020
lime brkn	3210
shale	3328
lime	3395
lime cherty	3411
lime	3602
shale	3641
lime brkn & shale	3670
shale & lime	3684
shale	3695
sand slight porosity & saturation	3698
shale	3704
lime	3717
shale sdy	3718
lime	3721
lime cherty	3725
lime dolomitic w/ chert strks	3733
dolomite sugary	3734
dolomite & chert strks	3743
chert	3744
chert & lime	3750
lime	3751
lime & chert	3788
chert wh	3790
lime dense	3804
Total Depth.	

Plugged back to 3740

Misener sand 3695-98
Viola 3704-40

Phy. pmpd Pot. produced
82.41 BO in 8 hrs