


Give All Information Completely
Make Required Affidavit
Mail or Deliver Report to:
Conservation Division
State Corporation Commission
211 No. Broadway
Wichita, Kansas

WELL PLUGGING RECORD

NORTH

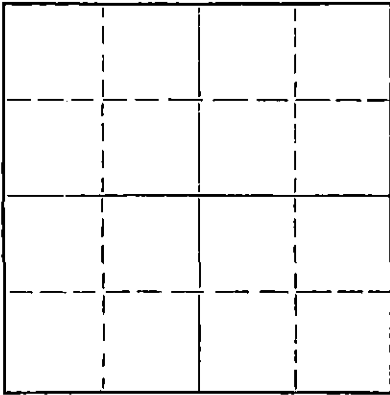

Locate well correctly on above
Section Plat

Pawnee County. Sec. 33 Twp. 22 Rge. 17 (E) W (W)
Location as "NE/CNW/SW" or footage from lines SW NW SE
Lease Owner Honaker-Davis Drlg. Co.
Lease Name Schartz Well No. 1
Office Address 2008 Lakin, Great Bend, Kansas
Character of Well (completed as Oil, Gas or Dry Hole) Dry Hole
Date well completed 5-7 19 57
Application for plugging filed 5-7 19 57
Application for plugging approved 5-7 19 57
Plugging commenced 5-7 6:00 P.M. 19 57
Plugging completed 5-7 7:30 P.M. 19 57
Reason for abandonment of well or producing formation _____

If a producing well is abandoned, date of last production _____ 19 _____
Was permission obtained from the Conservation Division or its agents before plugging was commenced? Yes

Name of Conservation Agent who supervised plugging of this well Mr. Brundege
Producing formation _____ Depth to top _____ Bottom _____ Total Depth of Well 4219 Feet
Show depth and thickness of all water, oil and gas formations.

OIL, GAS OR WATER RECORDS

CASING RECORD

FORMATION	CONTENT	FROM	TO	SIZE	PUT IN	PULLED OUT
				8-5/8	242	None

Describe in detail the manner in which the well was plugged, indicating where the mud fluid was placed and the method or methods used in introducing it into the hole. If cement or other plugs were used, state the character of same and depth placed, from _____ feet to _____ feet for each plug set.

Filled hole with heavy rotary mud to top of casing. Set plug.
Pumped plug down with 100 sack cement by Globe Cement.

(If additional description is necessary, use BACK of this sheet)

Name of Plugging Contractor _____
Address _____

STATE OF KANSAS, COUNTY OF BARTON, ss.
S. C. Lingreen (employee of owner) or (~~owner or operator~~) of the above-described well, being first duly sworn on oath, says: That I have knowledge of the facts, statements, and matters herein contained and the log of the above-described well as filed and that the same are true and correct. So help me God.

(Signature) S. C. Lingreen
Great Bend, Kansas
(Address)

SUBSCRIBED AND SWORN TO before me this 8th day of May, 1957

My commission expires 6-25-59

[Signature]
Notary Public.

PLUGGING
FILE SEC. 33 T. 22 R. (17)
BOOK PAGE 11 LINE 38

MAY 9 - 1957
CONSERVATION DIVISION
Wichita, Kansas
5-9-57

DRILLER'S LOG

Schartz No. 1
 Loc: SW NW SE
 Sec: 33-22S-17W
 Pawnee County, Kansas
 Company: Honaker-Davis Drlg. Co., et al
 Contractor: Honaker-Davis Drlg. Co.

Comm: 4-25-57
 Comp: 5-7-57
 Rotary Total Depth: 4219'
 Casing: 8-5/8" at 243'
 D & A


0	90	Sand	
90	150	Sand & Clay	
150	243	Blue Shale	8-5/8" casing cemented
243	375	Shale	at 243' with 175 sacks
375	525	Red Bed & Shale	cement and 4 sacks
525	615	Sand	calcium chloride.
615	850	Shale & Red Bed	
850	1080	Red Bed & Shale	
1080	1100	Anhydrite	
1100	1320	Shale & Shells	
1320	1660	Shale	
1660	4111	Lime & Shale	
4111	4213	Lime, Shale & Chert	
4213	4219	Lime & Chert	
4219		Rotary Total Depth	D & A

I certify that this is the true and correct copy of the
 above log to the best of my knowledge.



H. S. Forbes

Subscribed and sworn to before me this 8th day of
 May, 1957.

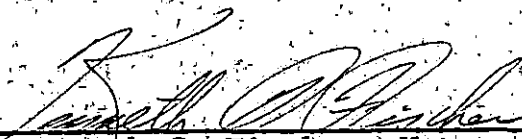

Kenneth G. Fischer, Notary Public

My commission expires: 6-25-59

PLUGGING			
FILE	SEC 33	T. 22	R. 17W
BOOK	PAGE 11	LINE	32

RECEIVED
 CORPORATION COMMISSION

MAY 9 - 1957

REGISTRATION DIVISION
 Pawnee County, Kansas