


STATE OF KANSAS
STATE CORPORATION COMMISSION

WELL PLUGGING RECORD

Give All Information Completely
Make Required Affidavit
Mail or Deliver Report to
Conservation Division
State Corporation Comm.
245 North Water
Wichita, KS 67202

Pawnee County, Sec. 33 Twp. 22S Rge. 17 E/W
Location as "NE/CNW/SW" or footage from lines
NE NW SW
Lease Owner Carstan Oil Co.
Lease Name Bennett Well No. 1
Office Address 8600 W. 63rd - Suite 307, Shawnee Mission, Ks.
Character of Well (Completed as Oil, Gas or Dry Hole) 66202
Dry Hole
Date Well completed 1-25 19 81
Application for plugging filed 1-25 19 81
Application for plugging approved 1-25 19 81
Plugging commenced 1-25 19 81
Plugging completed 1-25 19 81
Reason for abandonment of well or producing formation

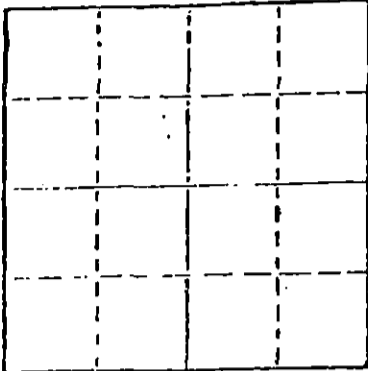

Locate well correctly on above Section Plot

If a producing well is abandoned, date of last production 19

Was permission obtained from the Conservation Division or its agents before plugging was commenced? Yes

Name of Conservation Agent who supervised plugging of this well Marion Smith
Producing formation Depth to top Bottom Total Depth of Well 4376'
Show depth and thickness of all water, oil and gas formations.

OIL, GAS OR WATER RECORDS

CASING RECORD

FORMATION	CONTENT	FROM	TO	SIZE	PUT IN	PULLED OUT
				8 5/8"	287'	None

Describe in detail the manner in which the well was plugged, indicating where the mud fluid was placed and the method or methods used in introducing it into the hold. If cement or other plugs were used, state the character of same and depth placed, from feet to feet for each plug set.

- 600' - 65 sx cement
- 240' - 30 sx cement
- 40' - 10 sx cement
- 5 sx in rathole
- 5 sx in water well

2-17-81

(If additional description is necessary, use BACK of this sheet)


Name of Plugging Contractor White & Ellis Drilling, Inc. FEB 17 1981
401 E. Douglas - Suite 500 Wichita, Kansas 67202

STATE OF Kansas COUNTY OF Sedgwick
Ernest Sifford (employee of owner) or (owner or operator)
of the above-described well, being first duly sworn on oath, says: That I have knowledge of the facts, statements, and matters herein contained and the log of the above-described well as filed and that the same are true and correct. So help me God.

(Signature) Ernest Sifford
401 E. Douglas - Suite 500 Wichita, Kansas
(Address) 67202

SUBSCRIBED AND SWORN TO before me this 30th day of January, 19 81

My commission expires

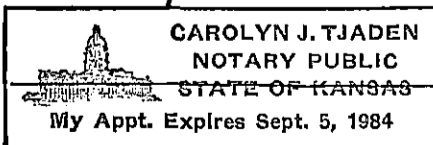

Carolyn J. Tjaden
Carolyn J. Tjaden Notary Public.

DRILLERS LOG

OPERATOR: Carstan Oil Co., 8600 W. 63rd - Suite 307, Shawnee Mission, Ks. 66202
CONTRACTOR: White & Ellis Drilling, Inc., Box 448, El Dorado, Kansas 67042

Lease Name Bennett Well No. 1
Sec. 33 T. 22S R. 17W Spot NE NW SW
County Pawnee State Kansas Elevation _____

Casing Record:
Surface: 8 5/8" @ 287' with 220 Sxs. 3% CC - 2% Gel
Production: _____ @ _____ with _____ Sxs.

Type Well: 1-16-81 Total Depth 1-25-81
Drilling Commenced: _____ Drilling Completed _____

Formation	From	To	Tops
Cellar	0	5	Dakota 533
Sand	5	40	Anhydrite 1079
Shale, Sand	40	1936	Kansas City 3829
Lime, Shale	1936	2904	
Lime	2904	4376	

RECEIVED
STATE DEPARTMENT OF COMMISSION
FEB 17 1981
CONSERVATION DIVISION
Wichita, Kansas

COMPLETION RECORD

Liner Record: Size _____ From _____ To _____
Cementing Record: _____ Sacks _____
Perforating Record: _____

Formation	Perforated Interval	Number Shots

Initial Production: _____

Electric Log	Type and Depths Covered