


STATE OF KANSAS  
STATE CORPORATION COMMISSION

Form CP-4

Give All Information Completely  
Make Required Affidavit  
Mail or Deliver Report to:  
Conservation Division  
State Corporation Commission  
212 No. Market  
Wichita, Kansas 67202

WELL PLUGGING RECORD

Pawnee County, Sec. 33 Twp. 22S Rge. 16 ~~(W)~~ (W)  
Location as "NE/CNW/SW" or footage from lines C NE NE  
Lease Owner Alpine Drilling Co., Inc.  
Lease Name Chesky Well No. 1  
Office Address 800 Bitting Building, Wichita, Kansas 67202  
Character of Well (completed as Oil, Gas or Dry Hole) Dry Hole  
Date well completed February 18 1976  
Application for plugging filed February 18 1976  
Application for plugging approved February 18 1976  
Plugging commenced February 18 1976  
Plugging completed February 18 1976  
Reason for abandonment of well or producing formation Non-producing in  
commerical quantities  
If a producing well is abandoned, date of last production \_\_\_\_\_ 19\_\_\_\_  
Was permission obtained from the Conservation Division or its agents before plugging was com-  
menced? Yes

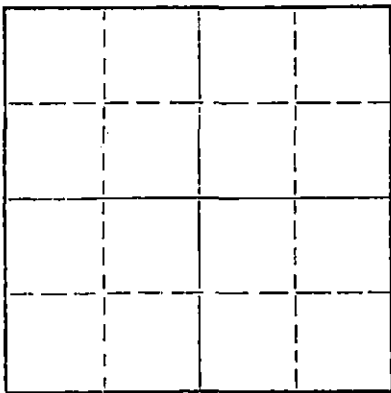

Locate well correctly on above  
Section Plat

Name of Conservation Agent who supervised plugging of this well Leo F. Massey  
Producing formation \_\_\_\_\_ Depth to top \_\_\_\_\_ Bottom \_\_\_\_\_ Total Depth of Well 4160 Feet  
Show depth and thickness of all water, oil and gas formations.

OIL, GAS OR WATER RECORDS

CASING RECORD

FORMATION	CONTENT	FROM	TO	SIZE	PUT IN	PULLED OUT
				8-5/8"	286'	

Describe in detail the manner in which the well was plugged, indicating where the mud fluid was placed and the method or methods used in introducing it into the hole. If cement or other plugs were used, state the character of same and depth placed, from \_\_\_\_\_ feet to \_\_\_\_\_ feet for each plug set.

Put in mud to 400'; 50 sacks cement at 400'.  
Mud to 240'; 25 sacks at 240'. Mud to 40';  
1 sack hulls and plug at 40'. 10 sacks cement  
to the top. Plugged 8:00 a.m., Feb. 18, 1976.

RECEIVED  
STATE CORPORATION COMMISSION

FEB 20 1976  
2-20-1976

CONSERVATION DIVISION  
Wichita, Kansas

(If additional description is necessary, use BACK of this sheet)  
Name of Plugging Contractor Allied Cementing Co., Inc.  
Address Box 31, Russell, Kansas

STATE OF Kansas, COUNTY OF Sedgwick, ss.  
Jon T. Williams, Jr. (employee of owner) or (owner or operator) of the above described

well, being first duly sworn on oath, says: That I have knowledge of the facts, statements, and matters herein contained and the log of the above-described well as filed and that the same are true and correct. So help me God.

(Signature) [Signature]  
800 Bitting Building, Wichita, KS 67202  
(Address)

SUBSCRIBED AND SWORN TO before me this 19th day of February, 1976

My commission expires February 23, 1976 Patricia J. Phillips Notary Public.

