

WELL PLUGGING RECORD


STATE OF KANSAS STATE CORPORATION COMMISSION

Give All Information Completely Make Required Affidavit Mail or Deliver Report to: Conservation Division, State Corporation Commission 800 Bittling Building Wichita, Kansas

FORMATION PLUGGING RECORD

Strike out upper line when reporting plugging of formations.

Pawnee County Sec. 34 Twp. 22S Rge. 16 (E) (W) Location as "NE 1/4 NW 1/4 SW 1/4" or footage from lines. 2310' NSL, 2310' EWL, NE, NE, SW Lease Owner Gulf Oil Corporation Lease Name B. C. Harris Well No. 1 Office Address Box 661, Tulsa, Oklahoma Character of Well (completed as Oil, Gas or Dry Hole) Dry Hole Date well completed September 17 1948 Application for plugging filed September 20 1948 Application for plugging approved September 20 1948 Plugging commenced September 20 1948 Plugging completed September 21 1948 Reason for abandonment of well or producing formation Dry Hole

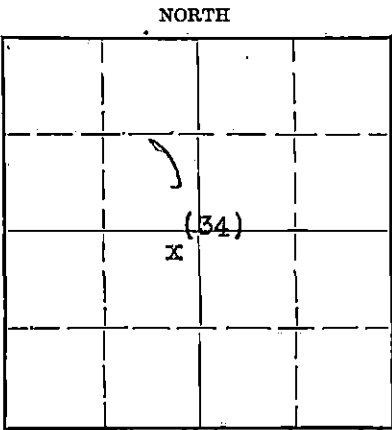

Locate well correctly on above Section Plat

Name of Conservation Agent who supervised plugging of this well C. D. Stough Producing formation Arbuckle Depth to top 4130' Bottom 4156' Total Depth of Well 4156' Feet Show depth and thickness of all water, oil and gas formations.


OIL, GAS OR WATER RECORDS

CASING RECORD

Table with 7 columns: Formation, Content, From, To, Size, Put In, Pulled Out. One entry: Size 12-1/4", Put In 1045', Pulled Out None.

Describe in detail the manner in which the well was plugged, indicating where the mud fluid was placed and the method or methods used in introducing it into the hole. If cement or other plugs were used, state the character of same and depth placed, from... feet to... feet for each plug set. Hole was mudded TD 4156' to 200'. 15 sacks Portland cement dumped at 200'. Hole mudded to 30'. Set HONCO plug at 30'. Filled hole to base of cellar with 12 sacks cement. Mudded hole through drill pipe.

10-7-48

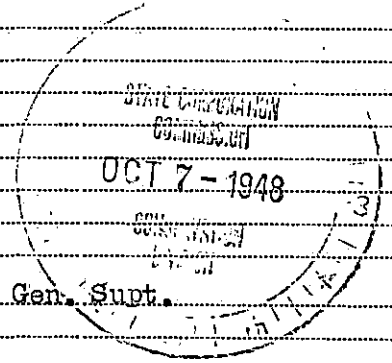

(If additional description is necessary, use BACK of this sheet) Correspondence regarding this well should be addressed to A. M. Bell, Jr., Gen. Supt. Address Box 661, Tulsa, Oklahoma

STATE OF Kansas, COUNTY OF Rice, ss. H. H. Wright (employee of owner) of the above-described well, being first duly sworn on oath, says: That I have knowledge of the facts, statements, and matters herein contained and the log of the above-described well as filed and that the same are true and correct. So help me God.

(Signature) H. H. Wright, Box 544, Chase Ks. (Address)

SUBSCRIBED AND SWORN to before me this 24th day of September, 1948. H. M. Council, Notary Public.

My commission expires April 14, 1952 22-2625 2-48-15M

PLUGGING FILE SEC 34 T 22S R 16W BOX PAGE 58 LINE 36



WELL RECORD

15-145-00458-0000

WELL NO. LEASE **D. Cook Harris** COMPANY **Gulf Oil Corporation** A.F.E. **3666**
 DATE—DRILLING BEGAN **8-30-48** **Plugging** WELLS COMPLETED **9-21-48** FIRST PRODUCTION
 SAND RECORD **Arbuckle 4130' - 4156'** TOTAL DEPTH **4156'**

INITIAL PRODUCTION **Dry hole. Plugged and abandoned.**

CASING RECORD

S— **34** T— **23** R— **167**

SIZE	WEIGHT	THD.	CLASS	MAKE	SET AT DEPTH	SACKS CEMENT	LBS. CAL. CHLO.	PULLED	LEFT IN
8-5/8"	32	10V	B	Smls	1039'	400			1039'

Center		Parish	
NI		County	
SV		Kansas	

DISTANCE H: Top collar on 8-5/8" is 14' below rotary bushing.

ELEVATION— 2061'

FORMATION RECORD:

	FROM	TO
Sand and shale	0'	350'
Shale and shells		460
Shale and sand		520
Sand		580
Shale and sand		700
Shale and shells		930
Anhydrite		1060
Red bed and shells		1400
Shale and shells		1565
Shale		1865
Shale and lime		2005
Lime and shale		2425
Lime		2535
Shale and lime		2575
Lime		2605
Lime and shale		2680
Shale and lime		2780
Lime and shale		2990
Shale and shells		3030
Lime and shale		3645
Shale and lime		3664
Lime, broken lime and chert		3720
Lime		4023
Broken lime and chert		4049
Lime and chert		4092
Lime and shale		4141
Lime		4156
TOTAL DEPTH		

ED:IMM
 October 5, 1948

