


WELL PLUGGING RECORD

Give All Information Completely  
Make Required Affidavit  
Mail or Deliver Report to:  
Conservation Division  
State Corporation Commission  
212 North Market, Insurance Bldg.  
Wichita, Kansas

Pawnee County, Sec. 34 Twp. 22S Rge. 16W (E) (W)

Location as "NE/CNW/SW" or footage from lines NE NE SE  
Lease Owner National Cooperative Refinery Association  
Lease Name Schartz-Bowman Well No. 1  
Office Address 305 Rule Building, Wichita, Kansas  
Character of Well (completed as Oil, Gas or Dry Hole) Gas  
Date well completed (Washdown of Dry Hole) October 15, 19 53  
Application for plugging filed March 25, 19 59  
Application for plugging approved March 26, 19 59  
Plugging commenced April 24, 19 59  
Plugging completed April 28, 19 59  
Reason for abandonment of well or producing formation Depletion

NORTH

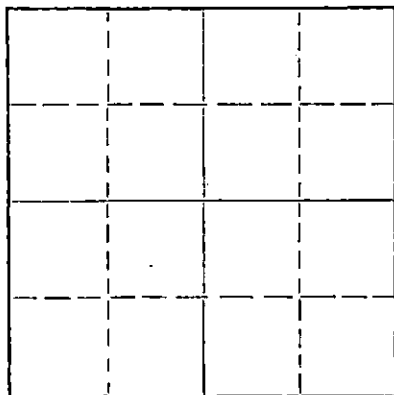

Locate well correctly on above Section Plat

If a producing well is abandoned, date of last production June 1, 19 58  
Was permission obtained from the Conservation Division or its agents before plugging was commenced? Yes

Name of Conservation Agent who supervised plugging of this well Frank Broadfoot  
Producing formation \_\_\_\_\_ Depth to top \_\_\_\_\_ Bottom \_\_\_\_\_ Total Depth of Well 4090 Feet  
Show depth and thickness of all water, oil and gas formations.

OIL, GAS OR WATER RECORDS

CASING RECORD

FORMATION	CONTENT	FROM	TO	SIZE	PUT IN	PULLED OUT
				8-5/8"	991'	None-Cemented
				5-1/2"	4082'	2092'
	No Log Available					

Describe in detail the manner in which the well was plugged, indicating where the mud fluid was placed and the method or methods used in introducing it into the hole. If cement or other plugs were used, state the character of same and depth placed, from \_\_\_\_\_ feet to \_\_\_\_\_ feet for each plug set.

Pulled 5 1/2" casing to approximately 1000', hooked up circulating pump and circulated pipe with 20 sacks of gel mud, pulled rest of 5 1/2" casing, cleared hole and bailed to 300'. Set rock bridge to 290' and dumped 20 sacks of cement. Mudded the hole to 40', set a 10' rock bridge and ran 10 sacks of cement to base of cellar.

RECEIVED  
STATE CORPORATION COMMISSION

MAY 27 1959

CONSERVATION DIVISION  
Wichita

(If additional description is necessary, use BACK of this sheet)  
Name of Plugging Contractor West Supply Company  
Address Chase, Kansas

STATE OF Kansas, COUNTY OF Sedgwick, ss.  
C. R. Sears (employee of owner) or (owner or operator) of the above-described well, being first duly sworn on oath, says: That I have knowledge of the facts, statements, and matters herein contained and the log of the above-described well as filed and that the same are true and correct. So help me God.

(Signature) C. R. Sears (C. R. Sears)

305 Rule Building, Wichita, Kansas  
(Address)

SUBSCRIBED AND SWORN to before me this 26th day of May, 1959

Nell McComb

My commission expires November 26, 1960

Nell McComb Notary Public.

PLUGGING  
FILE SEC 34 T 22 R 16W  
BOOK PAGE 25 LI. 30