


STATE OF KANSAS
STATE CORPORATION COMMISSION

WELL PLUGGING RECORD

Give All Information Completely
Make Required Affidavit
Mail or Deliver Report to:
Conservation Division
State Corporation Commission
211 No. Broadway
Wichita Kansas

Harvey County. Sec. 29 Twp. 22 Rge. 3 (E) W (W)
Location as "NE/CNW/SW" or footage from lines SW NE NW
Lease Owner Brunson Production & Exploration, Inc.
Lease Name Siemens Well No. 1
Office Address 333 1st Nat'l. Bank, Wichita, Kansas
Character of Well (completed as Oil, Gas or Dry Hole) Dry Hole
Date well completed 10-30-56
Application for plugging filed 10-30-56
Application for plugging approved 10-30-56
Plugging commenced 10-30-56
Plugging completed 10-30-56
Reason for abandonment of well or producing formation Dry Hole

NORTH

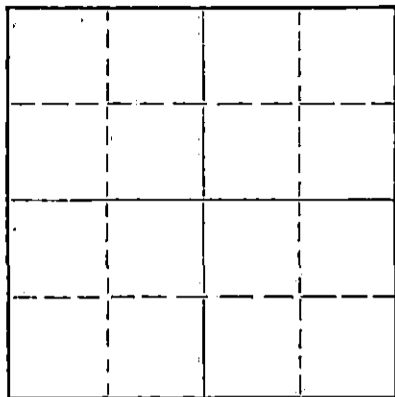

Locate well correctly on above
Section Flat

If a producing well is abandoned, date of last production _____ 19____
Was permission obtained from the Conservation Division or its agents before plugging was commenced? Yes

Name of Conservation Agent who supervised plugging of this well Ruel Durkee
Producing formation _____ Depth to top _____ Bottom _____ Total Depth of Well 3635 Feet
Show depth and thickness of all water, oil and gas formations.

OIL, GAS OR WATER RECORDS

CASING RECORD

FORMATION	CONTENT	FROM	TO	SIZE	PUT IN	PULLED OUT
				8 5/8	331'	none

Describe in detail the manner in which the well was plugged, indicating where the mud fluid was placed and the method or methods used in introducing it into the hole. If cement or other plugs were used, state the character of same and depth placed, from _____ feet to _____ feet for each plug set.

Pushed bottom plug to 310'. Secured with two strands HOWCO wire. Cemented with 15 sks cement, 1 sk hulls. Pushed top plug to 30'. Cemented with 10 sks cement, 1 sk hulls.

(If additional description is necessary, use BACK of this sheet)

Name of Plugging Contractor Brunson Production & Exploration, Inc.
Address 333 1st National Bank Bldg., Wichita, Kansas

STATE OF Kansas COUNTY OF Sedgwick, ss.
Ralph B. McLaughlin (employee of owner) or XXXXXXXXXX (owner or operator) of the above-described well, being first duly sworn on oath, says: That I have knowledge of the facts, statements, and matters herein contained and the log of the above-described well as filed and that the same are true and correct. So help me God.

(Signature) Ralph B. McLaughlin
(Address) _____

SUBSCRIBED AND SWORN to before me this 7th day of November, 19 56
My commission expires December 31, 1958
Donna L. Riley Notary Public.

PLUGGING
FILE SEC. 29 T 22 R 3W
BOOK PAGE 113 LINE 11

NOV - 8 1956 11-8-56
CONSERVATION DIVISION
Wichita, Kansas

BRUNSON PRODUCTION & EXPLORATION, INC.

WELL: SIEMENS # 1

SW NE NW

COMMENCED RD: 10-20-56
COMPLETED RD: 10-30-5629-22-3
HARVEY COUNTY

TOTAL DEPTH: 3635

ELEVATION: 1433

CASING: 331' 8 5/8" O.D.

CONTRACTOR: BRUNSON
PRODUCTION & EXPLORATION,
INC.

STRATA	DEPTH	TOPS
Surface Soil	20	Brown Lime 2457-1019
Clay	30	Lansing 2488-1050
Sand	240	Cherokee Shale 3092-1694
Shale	331	Mississippi 3214-1775
Shale & Lime	545	Kinderhook
Broken Lime	1075	Shale 3475-2037
Shale & Lime	1270	Masoner Sand 3566-2128
Shale	1630	Chattanooga
Shale & Lime	1710	Shale 3569-2131
Lime & Shale	2200	Hunton 3576-2138
Shale & Lime	2450	Maquoketa 3611-2173
Shale, Lime, & Chert	3242	Total Depth 3635
Lime, Chert & Shale	3376	D & A
Lime, Shale & Chert	3418	
Shale, Lime & Chert	3437	
Lime, Shale & Chert	3476	
Shale, Lime	3491	
Shale	3574	
Shale & Lime	3611	
Total Depth	3635	

I hereby certify that the above is a true and correct log of said well as reflected by the daily drilling reports.


BRUNSON PRODUCTION & EXPLORATION, INC.
BY

Ralph B. McLaughlin
Ralph B. McLaughlin, Secretary-Treasurer

Signed and sworn to in my presence this 2nd day of November, 1956, by
Ralph B. McLaughlin-Secretary-Treasurer of the Brunson Production & Exploration,
Inc., a Corporation in the State of Kansas.

Donna L. Riley
Donna L. Riley, Notary Public

My commission expires December 31, 1958.

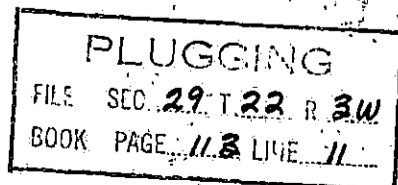

STATE COMMISSION

CONSERVATION