

**STATE CORPORATION COMMISSION OF KANSAS
OIL & GAS CONSERVATION DIVISION
WELL COMPLETION FORM
ACO-1 WELL HISTORY
DESCRIPTION OF WELL AND LEASE**

API NO. 15- 145-21,346-0000

County Pawnee

NE SE SE Sec. 34 Twp. 22 Rge. 16W X East West

990 Ft. North from Southeast Corner of Section

330 Ft. West from Southeast Corner of Section
(NOTE: Locate well in section plat below.)

Lease Name Wurm Well # #1

Field Name Shady

Producing Formation Lansing-Kansas City

Elevation: Ground 2031 KB 2036

Total Depth 4060' PBTD 4037

Operator: License # 5403

Name: Mr. Wayne Walcher

Address 701 Bitting Building

City/State/Zip Wichita, KS 67202

Purchaser: _____

Operator Contact Person: Mr. Wayne Walcher

Phone (316) 267-1611

Contractor: Name: Red Tiger Drilling

License: 5302

Wellsite Geologist: Wayne Walcher

Designate Type of Completion
 New Well Re-Entry Workover

Oil SWD Temp. Abd.
 Gas Inj Delayed Comp.
 Dry Other (Core, Water Supply, etc.)

If **OWHO**: old well info as follows:
Operator: _____


Well Name: _____

Comp. Date _____ Old Total Depth _____

Drilling Method:
 Mud Rotary Air Rotary Cable

11-20-90 11-29-90 11-30-90
Spud Date Date Reached TD Completion Date

RECEIVED
STATE CORPORATION COMMISSION
MAR - 7 1991
3-7-91
CONSERVATION DIVISION
Wichita, Kansas

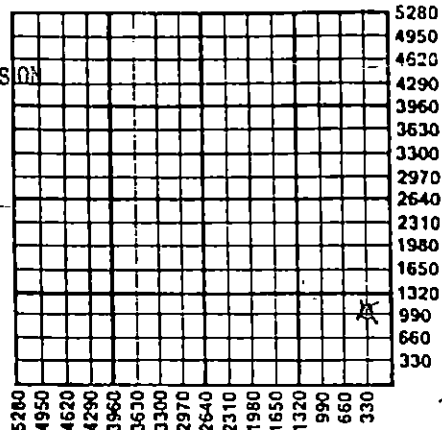

Amount of Surface Pipe Set and Cemented at 311' Feet

Multiple Stage Cementing Collar Used? Yes No

If yes, show depth set _____ Feet

If Alternate II completion, cement circulated from _____ feet depth to _____ w/ _____ sx cmt.

INSTRUCTIONS: This form shall be completed in triplicate and filed with the Kansas Corporation Commission, 200 Colorado Derby Building, Wichita, Kansas 67202, within 120 days of the spud date of any well. Rule 82-3-130, 82-3-107 and 82-3-106 apply. Information on side two of this form will be held confidential for a period of 12 months if requested in writing and submitted with the form. See rule 82-3-107 for confidentiality in excess of 12 months. One copy of all wireline logs and drillers time log shall be attached with this form. ALL CEMENTING TICKETS MUST BE ATTACHED. Submit CP-4 form with all plugged wells. Submit CP-111 form with all temporarily abandoned wells. Any recompletion, workover or conversion of a well requires filing of ACO-2 within 120 days from commencement date of such work.

All requirements of the statutes, rules and regulations promulgated to regulate the oil and gas industry have been fully complied with and the statements herein are complete and correct to the best of my knowledge.

Signature Wayne Walcher

Title Operator Date 3-6-91

Subscribed and sworn to before me this 6th day of March, 1991.

Notary Public Francis E. Barham

Date Commission Expires April 20, 1991

K.C.C. OFFICE USE ONLY

F Letter of Confidentiality Attached
C Wireline Log Received
C Drillers Timelog Received

Distribution

KCC SWD/Rep NGPA
 KGS Plug Other (Specify)

FRANCES E. BARHAM
Notary Public - State of Kansas
My Appt. Expires 4-30-91