


STATE OF KANSAS
STATE CORPORATION COMMISSION

WELL PLUGGING RECORD

Give All Information Completely
Make Required Affidavit
Mail or Deliver Report to
Conservation Division
State Corporation Comm.
245 North Water
Wichita, KS 67202

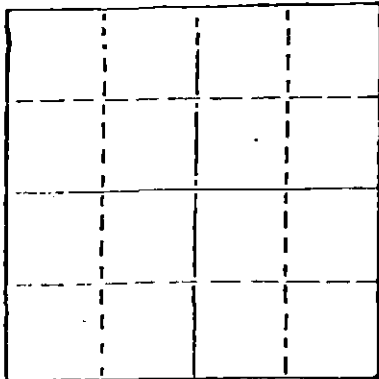

Locate well correctly on above
Section Plat

13.083.20775.00.00
Hodgeman County. Sec. 28 Twp. 21S Rge. 25 x R/W
Location as "NE/CNW1SW1" or footage from lines

SE NE

Lease Owner Cimarron Petroleum Corporation
Lease Name Clark Well No. #1-CPC 161

Office Address 900 Reunion Center Bldg., 9 E 4th, Tulsa, Ok.

Character of Well (Completed as Oil, Gas or Dry Hole)

Dry Hole

Date Well completed 11-3-80 19

Application for plugging filed 11-2-80 19

Application for plugging approved 11-2-80 19

Plugging commenced 11-2-80 19

Plugging completed 11-3-80 19

Reason for abandonment of well or producing formation

Commercial quantities of oil not found

If a producing well is abandoned, date of last production 19

Was permission obtained from the Conservation Division or
its agents before plugging was commenced? Yes

Name of Conservation Agent who supervised plugging of this well Clarence Thomas, Jr.

Producing formation Depth to top Bottom Total Depth of Well 4550'

Show depth and thickness of all water, oil and gas formations.

OIL, GAS OR WATER RECORDS

CASING RECORD

FORMATION	CONTENT	FROM	TO	SIZE	PUT IN	PULLED OUT
				8 5/8"	368'	None

Describe in detail the manner in which the well was plugged, indicating where the mud fluid was placed and the method or methods used in introducing it into the hold. If cement or other plugs were used, state the character of same and depth placed, from feet to feet for each plug set.

Plug @ 900' w/60 sx.

Plug @ 380' w/35 sx.

Plug @ 40' w/10 sx.

Rat Hole 5 sx.

RECEIVED
STATE CORPORATION COMMISSION
NOV 14 1980
CONSERVATION DIVISION
Wichita, Kansas

(If additional description is necessary, use BACK of this sheet)

Name of Plugging Contractor Rains & Williamson Oil Co., Inc.

STATE OF Kansas COUNTY OF Sedgwick, ss.

Wilson Rains, President of Rains & Williamson Oil Co., Inc. (employee of owner) or (owner or operator) of the above-described well, being first duly sworn on oath, says: That I have knowledge of the facts, statements, and matters herein contained and the log of the above-described well as filed and that the same are true and correct. So help me God.

(Signature) Wilson Rains

435 Page Court, 220 W. Douglas, Wichita, Ks. 67202

(Address)

SUBSCRIBED AND SWORN TO before me this 5 day of November, 19 80

My commission expires 10-4-83

Juanita M. Green

Notary Public.



15.083.20775.00.00

DRILLER'S LOG

COMPANY: Cimarron Petroleum Corporation

SEC. 28 T. 21S R. 25W

WELL NAME: Clark #1-CPC 161

LOC. C SE NE

COUNTY: Hodgeman

RIG NO. #2

TOTAL DEPTH 4550'

ELEVATION

COMMENCED: 10-25-80

COMPLETED: 11-3-80

CONTRACTOR: Rains & Williamson Oil Co., Inc.

CASING RECORD:

SURFACE: 8 5/8" @ 368' w/225 sx. common, 3% cc. & 2% gel.

PRODUCTION: D&A

LOG

(Figures Indicate Bottom of Formations)

Clay, Sand & Lime	285
Shale	950
Shale & Sand	1557
Shale	3323
Shale & Sand	3830
Shale	4382
Lime & Shale	4550
<u>ROTARY TOTAL DEPTH</u>	<u>4550</u>

RECEIVED
STATE APPROPRIATION COMMISSION

NOV 14 1980

CONSERVATION DIVISION
Wichita, Kansas

STATE OF Kansas)
COUNTY OF Sedgwick) SS:

I, Wilson Rains, President of Rains & Williamson Oil Co., Inc.

upon oath state that the above and foregoing is a true and correct copy of the log of the
Clark #1-CPC 161 well.

Wilson Rains
Wilson Rains

Subscribed and sworn to before me this 5 day of November, 1980.

My Appointment Expires:

10-4-83

Juanita M. Green
Juanita M. Green

