


WELL PLUGGING RECORD

Give All Information Completely  
Make Required Affidavit  
Mail or Deliver Report to:  
Conservation Division  
State Corporation Commission  
211 No. Broadway  
Wichita, Kansas

NORTH

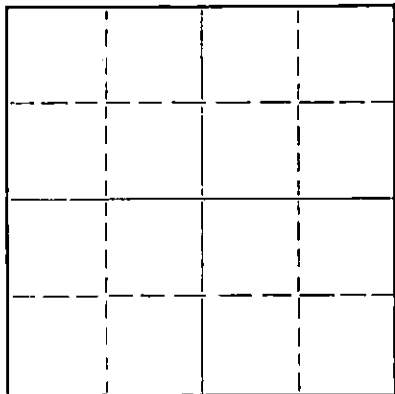

Locate well correctly on above Section Plat

Hodgeman County, Sec. 27 Twp. 21 S Rge. 25 ~~XXX~~ (W)  
Location as "NE/CNW/SW" or footage from lines C NW NE  
Lease Owner Stelbar Oil Corporation, Inc.  
Lease Name Sinclair Well No. 1  
Office Address 310 Petroleum Building, Wichita, Kansas 67202  
Character of Well (completed as Oil, Gas or Dry Hole) Dry Hole  
Date well completed November 26 19 64  
Application for plugging filed December 4 19 64  
Application for plugging approved December 2 19 64  
Plugging commenced November 25 19 64  
Plugging completed November 26 19 64  
Reason for abandonment of well or producing formation Dry Hole

If a producing well is abandoned, date of last production \_\_\_\_\_ 19 \_\_\_\_  
Was permission obtained from the Conservation Division or its agents before plugging was commenced? Yes

Name of Conservation Agent who supervised plugging of this well Hugh Scott  
Producing formation \_\_\_\_\_ Depth to top \_\_\_\_\_ Bottom \_\_\_\_\_ Total Depth of Well \_\_\_\_\_ Feet  
Show depth and thickness of all water, oil and gas formations.

OIL, GAS OR WATER RECORDS

CASING RECORD

FORMATION	CONTENT	FROM	TO	SIZE	PUT IN	PULLED OUT
				8-5/8	264	None

Describe in detail the manner in which the well was plugged, indicating where the mud fluid was placed and the method or methods used in introducing it into the hole. If cement or other plugs were used, state the character of same and depth placed, from \_\_\_\_\_ feet to \_\_\_\_\_ feet for each plug set.  
Filled hole with mud. Bottom plug at 700', cement with 25 sax Howco.  
Second plug at 300', cement with 25 sax Howco. Top plug at 45', cement with 15 sax.  
Top plug went down hole. Waited on cement and finished plugging hole.

RECEIVED  
STATE CORPORATION COMMISSION

DEC 7 1964

CONSERVATION DIVISION  
Wichita, Kansas

12-7-64

(If additional description is necessary, use BACK of this sheet)  
Name of Plugging Contractor S & S Drilling Company  
Address Great Bend, Kansas

STATE OF KANSAS, COUNTY OF SEDGWICK, ss.  
Bertrand M. Lester, Jr. (employee of owner) ~~XXXXXXXXXXXX~~ of the above-described

well, being first duly sworn on oath, says: That I have knowledge of the facts, statements, and matters herein contained and the log of the above-described well as filed and that the same are true and correct. So help me God.

(Signature) Bertrand M. Lester, Jr.  
310 Petroleum Building, Wichita, Kansas 67202  
(Address)

SUBSCRIBED AND SWORN to before me this Fourth day of December, 19 64

My commission expires May 7, 1966.  
Talia Zuhars Notary Public.

15.083.10323.00.00

WELL LOG

Sinclair #1  
C NW NE 27-21-25  
Hodgeman County, Kansas

<u>From</u>	<u>To</u>		<u>Elevation</u>	<u>2434</u>	<u>KB</u>
0	530	Shale and Shells			
530	535	Pyrite and Sand			
535	875	Shale and Red Bed			
875	1130	Shale and Shells			
1130	1340	Dakota Sand	Formation Tops		
1340	2310	Sandy Shale			
2310	2465	Lime and Shale	Anhydrite	1650	
2465	2620	Lime	Heebner	3844	
2620	3115	Lime and Shale	Lansing K. C.	3292	
3115	3155	Lime	Base K. C.	4270	
3155	4118	Lime and Shale	Marmaton	4298	
4118	4265	Lime	Fort Scott	4424	
4265	4282	Cherty Lime	Cherokee	4450	
4282	4420	Lime	Mississippi	4525	
4420	4475	Lime and Shale			
4475	4523	Lime			
4523	4530	Lime and Chert			
4530	4565	Mississippi			
4565		Total Depth			

STATE OF KANSAS  
DECEMBER 2 1964  
REGISTRATION DIVISION

STATE OF KANSAS.

COUNTY OF BARTON ss

T.D. Sweetman, Partner of S & S Drilling Company, Being first duly sworn on oath says: That I have knowledge of the facts, statements and matters herein contained and the log of the above described well as filed and that the same are true and correct.

T.D. Sweetman

Subscribed and sworn before me this 30th day of November, 1964.



Richard P. Simon

Notary Public

Barton County

My Commission Expires April 24, 1967