

STATE OF KANSAS
STATE CORPORATION COMMISSION


15.083.20954.00.00

WELL PLUGGING RECORD

Give All Information Completely
Make Required Affidavit
Mail or Deliver Report to
Conservation Division
State Corporation Comm.
245 North Water
Wichita, KS 67202

Hodgeman County, Sec. 24 Twp. 32S Rge. 25W E/W
Location as "NE/CNW $\frac{1}{4}$ /SW $\frac{1}{4}$ " or footage from lines
SW NW SE

Lease Owner BEREXCO INC.
Lease Name Wright Well No. 1
Office Address 401 E. Douglas, Suite 402, Wichita, Kansas 67202
Character of Well (Completed as Oil, Gas or Dry Hole) Dry Hole

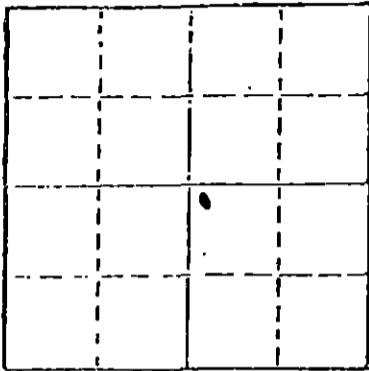

Locate well correctly on above
Section Plot

Date Well completed Jan. 6, 19 82
Application for plugging filed Jan. 6, 19 82
Application for plugging approved Jan. 6, 19 82
Plugging commenced Jan. 6, 19 82
Plugging completed Jan. 6, 19 82
Reason for abandonment of well or producing formation Dry Hole

If a producing well is abandoned, date of last production 19

Was permission obtained from the Conservation Division or its agents before plugging was commenced? Yes

Name of Conservation Agent who supervised plugging of this well Steve Durant
Producing formation Depth to top Bottom Total Depth of Well
Show depth and thickness of all water, oil and gas formations.

OIL, GAS OR WATER RECORDS

CASING RECORD

FORMATION	CONTENT	FROM	TO	SIZE	PUT IN	PULLED OUT

Describe in detail the manner in which the well was plugged, indicating where the mud fluid was placed and the method or methods used in introducing it into the hold. If cement or other plugs were used, state the character of same and depth placed, from feet to feet for each plug set.

Plugged with 50-50 Pozmix, 4% Gel, 3%CC
900' w/70 sks
450' w/40 sks
40' Plug & Halls w/ 10 sks
5 sks RH
5 sks MH

(If additional description is necessary, use BACK of this sheet)

Name of Plugging Contractor Halliburton


STATE OF Sedgwick COUNTY OF BEREDCO INC., ss.
Jerome D. Marcus (employee of owner) or (owner or operator)
of the above-described well, being first duly sworn on oath, says: That I have knowledge of the facts, statements, and matters herein contained and the log of the above-described well as filed and that the same are true and correct. So help me God.

(Signature) *J. Marcus*

SUBSCRIBED AND SWORN TO before me this 15th day of January, 19 82

Cheryl L. Benoit
Notary Public.
STATE CORPORATION COMMISSION

My commission expires 6-8-85

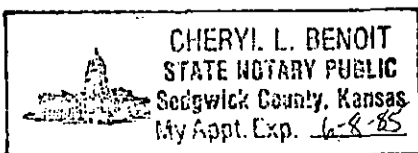

JAN 22 1982
CONSERVATION DIVISION
Wichita, Kansas