


STATE OF KANSAS
STATE CORPORATION COMMISSION

15-075-20105-0000

WELL PLUGGING RECORD

Give All Information Completely
Make Required Affidavit
Mail or Deliver Report to
Conservation Division
State Corporation Comm.
245 North Water
Wichita, KS 67202

Hamilton County, Sec. 8 Twp. 21S Rge. 40W E/W
Location as "NE/CNW/SW" or footage from lines
C-NE-SW (1980' FSL + 1980' FWL)
Lease Owner Dome Petroleum Corp.
Lease Name Spurland Well No. 1
Office Address Box 1047, Syracuse, Ks. 67878
Character of Well (Completed as Oil, Gas or Dry Hole)

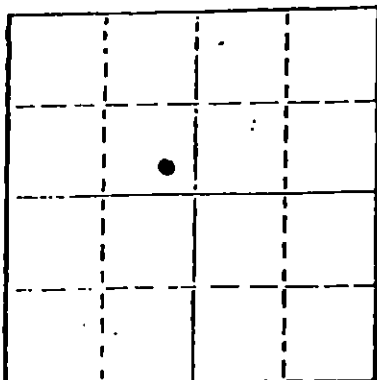

Locate well correctly on above Section Plot

Gas
Date Well completed 6-25 1975
Application for plugging filed 5-8 1980
Application for plugging approved 5-10 1980
Plugging commenced 7-11 1980
Plugging completed 7-11 1980
Reason for abandonment of well or producing formation

Non Commercial Value
If a producing well is abandoned, date of last production 19

Was permission obtained from the Conservation Division or its agents before plugging was commenced? Yes

Name of Conservation Agent who supervised plugging of this well Mr. Thomas
Producing formation Winfield Depth to top 2790 Bottom 2798 Total Depth of Well 12830
Show depth and thickness of all water, oil and gas formations.

OIL, GAS OR WATER RECORDS

CASING RECORD

FORMATION	CONTENT	FROM	TO	SIZE	PUT IN	PULLED OUT
Surface				8 5/8"	291.90	0
Production				4 1/2"	2828.65	0

Describe in detail the manner in which the well was plugged, indicating where the mud fluid was placed and the method or methods used in introducing it into the hold. If cement or other plugs were used, state the character of same and depth placed, from _____ feet to _____ feet for each plug set.

Pumped 1 sk hulls and 10 sks cement at bottom. Displaced to 350'
Pumped 30 sk Cement. Displaced to 60' pumped 5 sks cement 60' to 0'
Cut off 8 5/8: 48' below ground level.

(If additional description is necessary, use BACK of this sheet)

Name of Plugging Contractor Dowell Ulysses, Ks.

RECEIVED
JUL 23 1980
STATE CORPORATION COMMISSION
Wichita, Kansas

STATE OF Kansas COUNTY OF Hamilton
John Tracy, Jr. (employee of owner) or (owner or operator)
of the above-described well, being first duly sworn on oath, says: That I have knowledge of the facts, statements, and matters herein contained and the log of the above-described well as filed and that the same are true and correct. So help me God.

(Signature)

John Tracy, Jr.
Box 1047 Syracuse Ks. 67878
(Address)

SUBSCRIBED AND SWORN TO before me this 16 day of July, 19 80

Peggy S. Gould
Notary Public.

My commission expires Nov. 16, 1981