


STATE OF KANSAS
STATE CORPORATION COMMISSION

Form CP-4

15-075-20123-0000
WELL PLUGGING RECORD

Give All Information Completely
Make Required Affidavit
Mail or Deliver Report to:
Conservation Division
State Corporation Commission
P. O. Box 17027
Wichita, Kansas 67217
NORTH

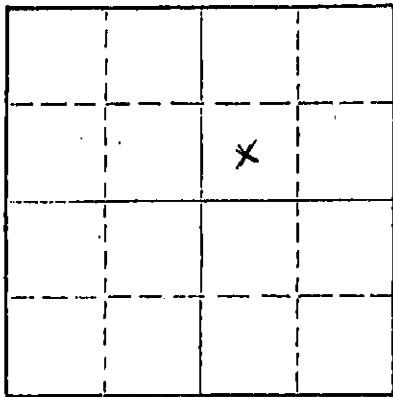

Locate well correctly on above Section Flat

Hamilton County. Sec. 27 Twp. 21S Rge. 40W ~~XX~~ (W)
Location as "NE/CNW&SW" or footage from lines C SW NE
Lease Owner Dome Petroleum (form. Computer Petroleum)
Lease Name Daskocil Well No. 1
Office Address 1600 Broadway, Denver, Colorado
Character of Well (completed as Oil, Gas or Dry Hole) Gas
Date well completed April 16 1976
Application for plugging filed October 4 1979
Application for plugging approved October 5 1979
Plugging commenced October 16 1979
Plugging completed October 16 1979
Reason for abandonment of well or producing formation Not commercially
productive.
If a producing well is abandoned, date of last production never produced 19__
Was permission obtained from the Conservation Division or its agents before plugging was commenced? Yes

Name of Conservation Agent who supervised plugging of this well Clarence Thomas
Producing formation Winfield Depth to top 2810 Bottom 2820 Total Depth of Well 2865 Feet
Show depth and thickness of all water, oil and gas formations.

OIL, GAS OR WATER RECORDS

CASING RECORD

FORMATION	CONTENT	FROM	TO	SIZE	PUT IN	PULLED OUT
Surface				8-5/8"	307.37'	0
Production				4-1/2"	2864.79'	0

Describe in detail the manner in which the well was plugged, indicating where the mud fluid was placed and the method or methods used in introducing it into the hole. If cement or other plugs were used, state the character of same and depth placed, from _____ feet to _____ feet for each plug set.

Pumped 15 sx cement w/ hulls 2627-2820'
Pumped mud 61-2627'
Pumped 5 sx cement 0- 61'
Cut off pipe 3' below ground level.

RECEIVED
STATE CORPORATION COMMISSION
OCT 18 1979
CONSERVATION DIVISION
Wichita, Kansas
10-18-79

(If additional description is necessary, use BACK of this sheet)
Name of Plugging Contractor Halliburton Services
Address Lamar, Colorado

STATE OF KANSAS, COUNTY OF SEWARD, ss.
R. L. Higginbottom, agent (employee of owner) or (owner or operator) of the above-described well, being first duly sworn on oath, says: That I have knowledge of the facts, statements and matters herein contained and the log of the above-described well as filed and that the same are true and correct. So help me God.

(Signature) R. L. Higginbottom
Box 6; Liberal, Kansas 67901
(Address)

SUBSCRIBED AND SWORN TO before me this 17th day of October, 19 79

My commission expires _____
A. J. PARNELL
Seward County, Kansas
My Appt. Exp. 7-7-81

A. J. Parnell
Notary Public.