

WELL PLUGGING RECORD


15-075-00024-0000

Give All Information Completely  
Make Required Affidavit  
Mail or Deliver Report to:  
Conservation Division  
State Corporation Commission  
212 North Market, Insurance Bldg.  
Wichita, Kansas

Hamilton County, Sec. 21 Twp. 21S Rge. 41W (E) (W)

Location as "NE/CNW/SW" or footage from lines NW SE  
Lease Owner LVO Corporation  
Lease Name A. M. Howell Well No. 1  
Office Address P. O. Box 2848, Tulsa, Oklahoma 74101  
Character of Well (completed as Oil, Gas or Dry Hole) Gas  
Date well completed 9 -3 19 60  
Application for plugging filed 3-28 19 72  
Application for plugging approved 3-30 19 72  
Plugging commenced 4-24 19 72  
Plugging completed 4-25 19 72  
Reason for abandonment of well or producing formation Uneconomical

NORTH

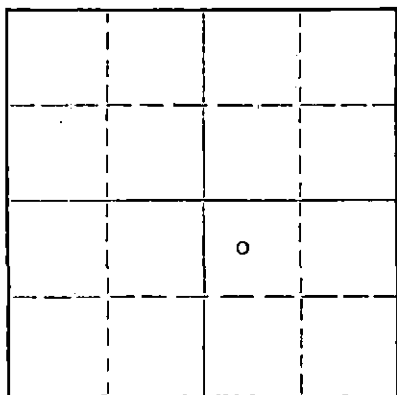

Locate well correctly on above Section Plat

If a producing well is abandoned, date of last production 19  
Was permission obtained from the Conservation Division or its agents before plugging was commenced? Yes

Name of Conservation Agent who supervised plugging of this well Ed Eves  
Producing formation Winfield Depth to top 2759 Bottom 2795 Total Depth of Well 2813 Feet  
Show depth and thickness of all water, oil and gas formations.

OIL, GAS OR WATER RECORDS

CASING RECORD

FORMATION	CONTENT	FROM	TO	SIZE	PUT IN	PULLED OUT
				4-1/2	2813	1426

Describe in detail the manner in which the well was plugged, indicating where the mud fluid was placed and the method or methods used in introducing it into the hole. If cement or other plugs were used, state the character of same and depth placed, from 2813 feet to 0 feet for each plug set.

One plug set @ 1426' with 20 sks cement and 1 sk hulls.  
One plug set @ 320' with 35 sks cement.  
One plug set @ 45' with 15 sks cement.

RECEIVED  
STATE CORPORATION COMMISSION

MAY 5 - 1972  
CONSERVATION DIVISION  
Wichita, Kansas

05-05-72

(If additional description is necessary, use BACK of this sheet)

Name of Plugging Contractor Sargent's Casing Pulling Service  
Address Box 506, Liberal, Kansas 67901

STATE OF Oklahoma, COUNTY OF Tulsa, ss.  
Larry T. Byrd (employee of owner) ~~or (owner or operator)~~ of the above-described well, being first duly sworn on oath, says: That I have knowledge of the facts, statements, and matters herein contained and the log of the above-described well as filed and that the same are true and correct. So help me God.

(Signature) Larry T. Byrd  
P. O. Box 2848, Tulsa, Oklahoma 74101  
(Address)

SUBSCRIBED AND SWORN TO before me this 5th day of May, 19 72

Margaret Heath  
Notary Public.

Commission expires 8-10-73