

STATE OF KANSAS  
STATE CORPORATION COMMISSION


Give All Information Completely  
Make Required Affidavit  
Mail or Deliver Report to:  
Conservation Division  
State Corporation Commission  
212 North Market, Insurance Bldg.  
Wichita, Kansas

15-075-10060-0000  
WELL PLUGGING RECORD

Hamilton County, Sec. 17 Twp. 21S Rge. XX 41 (W)

Location as "NE/CNW/SW" or footage from lines C NW SE  
Lease Owner LVO CORPORATION  
Lease Name 1711 Well No. 1  
Office Address P. O. Box 2848  
Character of Well (completed as Oil, Gas or Dry Hole) Gas  
Date well completed December 9 19 63  
Application for plugging filed September 7 19 71  
Application for plugging approved 19  
Plugging commenced September 7 19 71  
Plugging completed September 10 19 71  
Reason for abandonment of well or producing formation Depleted

NORTH

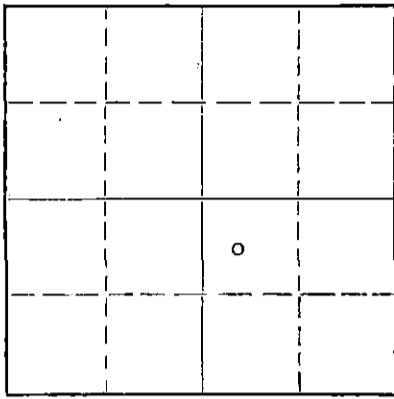

Locate well correctly on above Section Plat

If a producing well is abandoned, date of last production 19  
Was permission obtained from the Conservation Division or its agents before plugging was commenced?

Name of Conservation Agent who supervised plugging of this well  
Producing formation Depth to top Bottom Total Depth of Well Feet  
Show depth and thickness of all water, oil and gas formations.

OIL, GAS OR WATER RECORDS

CASING RECORD

FORMATION	CONTENT	FROM	TO	SIZE	PUT IN	PULLED OUT
				8-5/8"	121'	
				4-1/2"	2,793'	2252

Describe in detail the manner in which the well was plugged, indicating where the mud fluid was placed and the method or methods used in introducing it into the hole. If cement or other plugs were used, state the character of same and depth placed, from feet to feet for each plug set.

Mixed 20 sx plug with top @ 2616'.  
Mixed 40 sx plug at 175' to 75'.  
15 sx plug 45' to 0'.

RECEIVED  
STATE CORPORATION COMMISSION  
SEP 15 1971  
CONSERVATION DIVISION  
Wichita, Kansas  
09-15-71

(If additional description is necessary, use BACK of this sheet)

Name of Plugging Contractor Sargents Casing Pulling Service  
Address P. O. Box 506, Liberal, Kansas 67901

STATE OF OKLAHOMA COUNTY OF TULSA, ss.  
J. N. Sanford, Drilling Engineer (employee of owner) or (owner or operator) of the above-described well, being first duly sworn on oath, says: That I have knowledge of the facts, statements, and matters herein contained and the log of the above-described well as filed and that the same are true and correct. So help me God.

(Signature) *J. N. Sanford*  
P. O. Box 2848, Tulsa, Oklahoma 74101  
(Address)

SUBSCRIBED AND SWORN TO before me this 14th day of September, 19 71

*Margaret Heath*

Notary Public.

My commission expires 8-10-73



*Kearney Co. Society  
Sponsored  
Log*

LEASER: UNIT NO. 1711  
 OWNER: LIVINGSTON OIL COMPANY  
 CONTRACTOR: EARL F. WAKEFIELD  
 COM: 10-6-63  
 COMP: 10-9-63

LOCATION: NW SE  
 SECTION 17-215-41W  
 HAMILTON COUNTY, KANSAS  
 CASING: 8 5/8" Set at 121'  
 4 1/2" Set at 2793'

Surface Soil	40
Sand and Clay	65
Shale	95
Blue Shale	123
Shale and Shells	575
Sand and Shale	645
Shale and Shells	970
Shale	1365
Shale and Anhydrite, Red Beds	1780
Salt and Shale	1895
Salt and Shale	2040
Red Bed and Shale	2230
Shale and Shells	2329
Anhydrite	2349
Shale and Shells	2420
Shale and Lime	2684
Shale and Lime w/ red beds	2800
RFD	2800

RECEIVED  
 STATE CORPORATION COMMISSION  
 SEP 9 1971  
 CONSERVATION DIVISION  
 Wichita, Kansas

STATE OF KANSAS }  
 COUNTY OF SEDGWICK } SS

I hereby certify that the above is a true and correct copy of the log on the UNIT NO. 1711 well, located NW SE of Section 17-215-41W, Hamilton County, Kansas.

EARL F. WAKEFIELD

BY *Earl F. Wakefield*

Subscribed and sworn before me this 15 day of October, 1963.

My commission expires:  
January 25, 1965

*Wanda W. Riley*  
 WANDA W. RILEY NOTARY