


WELL PLUGGING RECORD

Give All Information Completely
Make Required Affidavit
Mail or Deliver Report to:
Conservation Division
State Corporation Commission
211 No. Broadway
Wichita, Kansas

Hodgeman County. Sec. 26 Twp. 22S Rge. 23 (E) W (W)
Location as "NE/CNW&SW&" or footage from lines SE/4 NE/4
Lease Owner Birmingham-Bartlett Drilling Co.
Lease Name KATZ Well No. 1
Office Address 300 Kaufman Bldg., Wichita, Kansas 67202
Character of Well (completed as Oil, Gas or Dry Hole) Dry Hole
Date well completed October 3, 19 64
Application for plugging filed (verbal) October 3, 19 64
Application for plugging approved (verbal) October 3, 19 64
Plugging commenced October 3, 19 64
Plugging completed October 4, 19 64
Reason for abandonment of well or producing formation _____

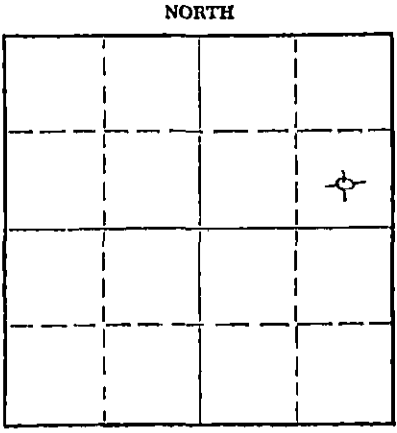

Locate well correctly on above
Section Plat

If a producing well is abandoned, date of last production _____ 19____
Was permission obtained from the Conservation Division or its agents before plugging was commenced? Yes

Name of Conservation Agent who supervised plugging of this well Hugh Scott
Producing formation _____ Depth to top _____ Bottom _____ Total Depth of Well 4572 Feet
Show depth and thickness of all water, oil and gas formations.

OIL, GAS OR WATER RECORDS CASING RECORD

FORMATION	CONTENT	FROM	TO	SIZE	PUT IN	PULLED OUT
		0	238'	8-5/8"	238'	none

Describe in detail the manner in which the well was plugged, indicating where the mud fluid was placed and the method or methods used in introducing it into the hole. If cement or other plugs were used, state the character of same and depth placed, from _____ feet to _____ feet for each plug set.

25 sacks cement spotted through drill pipe at 700'.
25 sacks cement spotted through drill pipe at 240'.
10 sacks cement at 40'.
filled with mud to surface.

10-7-64
RECEIVED
STATE CORPORATION COMMISSION

OCT 7 1964

CONSERVATION DIVISION
Wichita, Kansas

(If additional description is necessary, use BACK of this sheet)
Name of Plugging Contractor Birmingham-Bartlett Drilling Co.
Address 300 Kaufman Bldg., Wichita, Kansas 67202

STATE OF KANSAS COUNTY OF SEDGWICK
Richard Hindery, partner of Birmingham-Bartlett Drilling Co., owner, operator & contractor
(employee of owner) or (owner or operator) of the above-described
well, being first duly sworn on oath, says: That I have knowledge of the facts, statements, and matters herein contained and the log of the
above-described well as filed and that the same are true and correct. So help me God. BIRMINGHAM-BARTLETT DRILLING CO.

(Signature) By Richard Hindery Partner
300 Kaufman Bldg., Wichita, Kansas 67202
(Address)

SUBSCRIBED AND SWORN TO before me this 6th day of October, 19 64.

My commission expires October 2, 1966.
Beverly Larson
Beverly Larson Notary Public.

KATZ NO. 1 WELL

LOCATION: SE/4 NE/4
Section 26-22S-23W
Hodgeman County, Kansas

SPUDED: 9-22-64
ROTARY DRILLING
COMPLETED: 10-3-64

OWNER, OPERATOR
and CONTRACTOR: Birmingham-Bartlett Drilling Co.
300 Kaufman Building
Wichita, Kansas 67202

SURFACE CASING: 8-5/8" 20# casing cemented at
238' with 180 sacks cement.

OIL STRING: None set. Dry hole.
Plugging completed 10-4-64.

LOG

(Figures indicate bottom of formation)

0 -	50	Surface clay and post rock
	560	Shale and shells
	787	Red bed and shale
	831	Blaine Anhydrite
	915	Shale and shells
	1152	Sand
	1428	Shale and shells
	1464	Anhydrite - Stone Corral
	2210	Shale and shells
	3870	Shale and lime
	3920	Lime
	3998	Shale and lime
	4051	Lime
	4225	Shale and lime
	4354	Lime
	4401	Shale and lime
	4515	Lime
	4522	Cherty lime
	4572	Lime
	4572	Rotary total depth

RECEIVED
STATE CORPORATION COMMISSION

OCT 7 1964

CONSERVATION DIVISION
Wichita, Kansas

The undersigned, Richard Hindery, one of the partners of Birmingham-Bartlett Drilling Co., hereby certifies that the above is a true and correct log of the KATZ NO. 1 WELL as shown in the daily drilling reports.

BIRMINGHAM-BARTLETT DRILLING CO.

By Richard Hindery
Richard Hindery, Partner

Subscribed and sworn to before me
this 6th day of October, 1964.

Beverly Larson

Beverly Larson, Notary Public
My commission expires October 2, 1966.