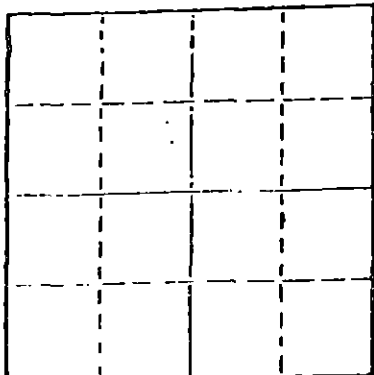


STATE OF KANSAS
STATE CORPORATION COMMISSION

WELL PLUGGING RECORD

Give All Information Completely
Make Required Affidavit
Mail or Deliver Report to
Conservation Division
State Corporation Comm.
245 North Water
Wichita, KS 67202

Locate well correctly on above
Section Plat

Hodgeman County. Sec. 25 Twp. 22S Rge. 23W E/4
Location as "NE/CNW $\frac{1}{4}$ SW $\frac{1}{4}$ " or footage from lines
100' S of C-SE NE

Lease Owner Tolco Oil & Gas
Lease Name Ewy Well No. 1
Office Address Box 867, Magnolia, Arkansas 71753
Character of Well (Completed as Oil, Gas or Dry Hole) Dry Hole

Date Well completed June 10, 1979
Application for plugging filed Verbal Application 19
Application for plugging approved Verbal Approval 19
Plugging commenced June 10, 1979
Plugging completed June 10, 1979
Reason for abandonment of well or producing formation

If a producing well is abandoned, date of last production 19

Was permission obtained from the Conservation Division or
its agents before plugging was commenced? Yes

Name of Conservation Agent who supervised plugging of this well Clarence Thomas
Producing formation _____ Depth to top _____ Bottom _____ Total Depth of Well 4,617'
Show depth and thickness of all water, oil and gas formations.

OIL, GAS OR WATER RECORDS

CASING RECORD

FORMATION	CONTENT	FROM	TO	SIZE	PUT IN	PULLED OUT
				8-5/8"	299'	None

Describe in detail the manner in which the well was plugged, indicating where the mud fluid
was placed and the method or methods used in introducing it into the hold. If cement or other
plugs were used, state the character of same and depth placed, from _____ feet to
_____ feet for each plug set.

Filled hole with heavy rotary mud from 4,617 ft. (rotary total depth) to
900 ft. Set plug at 900 ft. and cemented with 60 sacks cement. Filled
hole with heavy rotary mud from 900 ft. to 370 ft. Set plug at 370 ft.
and cemented with 35 sacks cement. Filled hole with heavy rotary mud
from 370 ft. to 40 ft. Set solid plug at 40 ft. and cemented to cellar
with 10 sacks cement, 5 sacks cement in rat hole.

Plugging operations accomplished utilizing Sun Oil Well cementing
pump truck through 4½ inch drill pipe.

RECEIVED

(If additional description is necessary, use BACK of this sheet)

Name of Plugging Contractor Sun Oil Well Cementing, Inc.Box 169, Great Bend, Kansas 67530STATE OF Kansas COUNTY OF SedgwickDean Britting, AgentCONSERVATION DIVISION
Wichita, KS.~~XXXXXXXXXXXXXXXXXXXX~~ of owner ~~XXXXXXXXXXXXXXXXXXXX~~

of the above-described well, being first duly sworn on oath, says: That I have knowledge of
the facts, statements, and matters herein contained and the log of the above-described well
as filed and that the same are true and correct. So help me God.

(Signature) Dean Britting200 N. Main, Wichita, Kansas 67202

(Address)

SUBSCRIBED AND SWORN TO before me this 13th day of June, 1979Elsie Willison

Elsie Willison -

Notary Public.

My commission expires July 25, 1982

KANSAS DRILLERS LOG

COMPANY Tolco Oil & Gas

SEC. 25 T. 22S R. 23W
LOC. 100' S of C-SE NE

FARM Ewy

NO. 1

COUNTY Hodgeman

ROTARY TOTAL DEPTH 4,617'

COMM. June 2, 1979

COMP. June 10, 1979

CONTRACTOR H-30, Inc. (Wig #3)

ISSUED June 13, 1979

CASING

10 3/4"

8 5/8" Set at 299' cemented w/200 sxs cement

ELEVATION 2,263' GR.

5 1/2"

4 1/2"

FIGURES INDICATE BOTTOM OF FORMATIONS

Sand and Shale	300'
Shale and Lime	860'
Red Bed and Shale	1,645'
Shale and Lime	3,370'
Shale	3,544'
Lime and Shale	4,510'
Lime	4,617'
Rotary Total Depth	4,617'

I hereby certify the above and foregoing to be
a true and correct log of the above described
well as shown by the drilling reports.

H-30, Inc.


 Dean Britting

State of Kansas

County of Sedgwick

SS:

Subscribed and Sworn to before me a Notary Public
in and for said county and state this 13th day of
June, 1979.

 RECEIVED
 STATE CORPORATION COMMISSION

JUN 14 1979


 Elsie Willison Notary Public

My Commission Expires:

July 25, 1982