


Give All Information Completely
Make Required Affidavit
Mail or Deliver Report to:
Conservation Division
State Corporation Commission
211 No. Broadway
Wichita, Kansas

WELL PLUGGING RECORD

Pawnee County, Sec. 36 Twp. 22 Rge. (E) 17 (W)
Location as "NE/CNW/SW" or footage from lines NW NW SE
Lease Owner Colorado Oil and Gas Corporation
Lease Name Kell Well No. 1
Office Address P. O. Box 1030, Wichita, Kansas
Character of Well (completed as Oil, Gas or Dry Hole) Gas
Date well completed October 26 19 55
Application for plugging filed March 25 19 64
Application for plugging approved March 26 19 64
Plugging commenced March 28 19 64
Plugging completed April 4 19 64
Reason for abandonment of well or producing formation Producent zone depleted.

NORTH

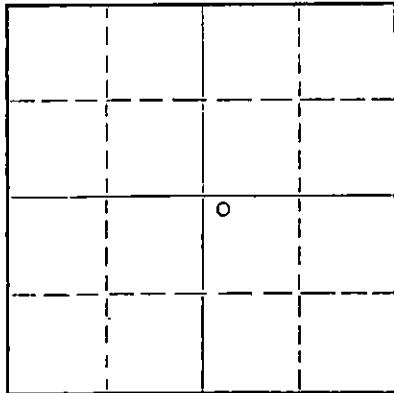

Locate well correctly on above
Section Plat

If a producing well is abandoned, date of last production March 27 19 64
Was permission obtained from the Conservation Division or its agents before plugging was commenced? Yes

Name of Conservation Agent who supervised plugging of this well Eldon Petty
Producing formation Conglomerate Chert Depth to top 4125 Bottom Total Depth of Well PB 4182 Feet
Show depth and thickness of all water, oil and gas formations.

OIL, GAS OR WATER RECORDS

CASING RECORD

FORMATION	CONTENT	FROM	TO	SIZE	PUT IN	PULLED OUT
				8-5/8"	243	None
				5-1/2"	4200	3245

Describe in detail the manner in which the well was plugged, indicating where the mud fluid was placed and the method or methods used in introducing it into the hole. If cement or other plugs were used, state the character of same and depth placed, from feet to feet for each plug set.

Dug out cellar. Rigged up unit. Sanded 60' off bottom.

Sanded 15' off bottom. Cemented bottom w/4 sax cement. Shot pipe at 3545'. Circulating. Spotted 60 bbls. of oil.

Working pipe. Shot pipe at 3400' - 3300' - 3215'.

Working pipe.

Pulling pipe.

Squeezed 8-5/8" casing w/80 sax cement & 20 sax of mud.

5-19-64

RECEIVED
STATE CORPORATION COMMISSION

MAY 19 1964

CONSERVATION DIVISION
Wichita, Kansas

(If additional description is necessary, use BACK of this sheet)

Name of Plugging Contractor Forbes Casing Pulling, Inc.
Address P. O. Box 221, Great Bend, Kansas

STATE OF Kansas, COUNTY OF Sedgwick, ss.

Bill K. Henrichs

(employee of owner) or (owner or operator) of the above-described

well, being first duly sworn on oath, says: That I have knowledge of the facts, statements, and matters herein contained and the log of the above-described well as filed and that the same are true and correct. So help me God.

(Signature) Bill K. Henrichs

P. O. Box 1030, Wichita, Kansas 67201
(Address)

SUBSCRIBED AND SWORN TO before me this 18th day of May 19 64

Helen L. Martin

Notary Public.

My commission expires August 19, 1967

