


STATE OF KANSAS
STATE CORPORATION COMMISSION

WELL PLUGGING RECORD

Give All Information Completely
Make Required Affidavit
Mail or Deliver Report to
Conservation Division
State Corporation Comm.
245 North Water
Wichita, KS 67202

Pawnee County. Sec. 36 Twp. 22 Rge. 17 E/W
Location as "NE/CNW $\frac{1}{4}$ /SW $\frac{1}{4}$ " or footage from lines C SE/4

Lease Owner Halliburton Oil Producing Co.
Lease Name Frick #1 Well No. _____
Office Address Stafford, Kansas 67578
Character of Well (Completed as Oil, Gas or Dry Hole) _____

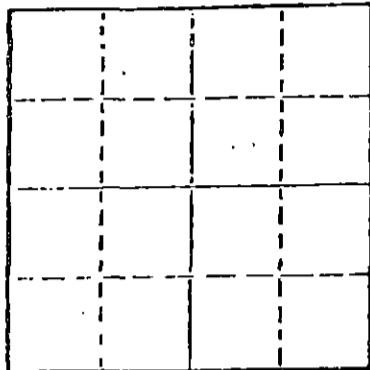

Locate well correctly on above
Section Plat

Date Well completed _____ 19____
Application for plugging filed _____ 19____
Application for plugging approved _____ 19____
Plugging commenced 7/9/79 19____
Plugging completed 7/12/79 19____
Reason for abandonment of well or producing formation
depleted.

If a producing well is abandoned, date of last production _____ 19____

Was permission obtained from the Conservation Division or
its agents before plugging was commenced? yes

Name of Conservation Agent who supervised plugging of this well Schmidt
Producing formation _____ Depth to top _____ Bottom _____ Total Depth of Well 4270
Show depth and thickness of all water, oil and gas formations.

OIL, GAS OR WATER RECORDS

CASING RECORD

| FORMATION | CONTENT | FROM | TO | SIZE | PUT IN | PULLED OUT |
|-----------|---------|------|----|--------|--------|------------|
| | | | | 8-5/8 | 315 | none |
| | | | | 4 1/2" | 4269 | 3012' |
| | | | | | | |
| | | | | | | |

Describe in detail the manner in which the well was plugged, indicating where the mud fluid was placed and the method or methods used in introducing it into the hold. If cement or other plugs were used, state the character of same and depth placed, from _____ feet to _____ feet for each plug set.

Put control head on. Allied pumped 25 sacks cement on bottom. Loaded hole with salt water, shot pipe at 3413', 3219', 3023', pulled 94 joints and tallied pipe. Allied pumped 5 sacks hulls, 25 sacks gel, 135 sacks cement, 50-50 pos, 6% gel. PLUGGING COMPLETE.

RECEIVED
STATE CORPORATION COMMISSION

JUL 20 1979

7-20-79

(If additional description is necessary, use BACK of this sheet)

Name of Plugging Contractor KELSO CASING PULLING
CHASE, KANSAS

STATE OF KANSAS COUNTY OF RICE, ss.
R. DARRELL KELSO (employee of owner) or (owner or operator)
of the above-described well, being first duly sworn on oath, says: That I have knowledge of the facts, statements, and matters herein contained and the log of the above-described well as filed and that the same are true and correct. So help me God.

(Signature) R. Darrell Kelso
CHASE, KANSAS
(Address)

SUBSCRIBED AND SWORN TO before me this 18th day of July, 1979

My commission expires _____



Margaret Melcher
Notary Public.

DRILLER'S LOG

Company: HALLIBURTON OIL PRODUCING COMPANY
 Contractor: MERCKLE DRILLING COMPANY
 Lease: Frick #1 Commenced: 4-12-79
 Location: C SE/4 36-22S-17W Completed: 4-20-79
 Pawnee County, Kansas
 Casing: 8-5/8" @ 315' w/200 sx.
 4-1/2" @ 4269' w/150 sx.

.....

| | |
|--------------|---------------------------|
| 0 - 327' | Surface soil, shale, sand |
| 327 - 565' | Shale |
| 565 - 635' | Sand |
| 635 - 1100' | Shale |
| 1100 - 1120' | Anhydrite |
| 1120 - 1995' | Shale |
| 1995 - 3125' | Shale and lime |
| 3125 - 3370' | Shale |
| 3370 - 4120' | Shale and lime |
| 4120 - 4270' | Lime |
| 4270' | Rotary T.D. |

RECEIVED
 STATE CORPORATION COMMISSION

JUN - 8 1979

CONSERVATION DIVISION
 Wichita, Kansas