

STATE OF KANSAS
STATE CORPORATION COMMISSION

WELL PLUGGING RECORD

Give All Information Completely
Make Required Affidavit
Mail or Deliver Report to
Conservation Division
State Corporation Comm.
245 North Water
Wichita, KS 67202

Pawnee County, Sec. 36 Twp. 22 Rge. 17 E/W

Location as "NE/CNW $\frac{1}{4}$ /SW $\frac{1}{4}$ " or footage from lines
NW SW SE

Lease Owner Halliburton Oil Producing Co.

Lease Name Frick #2 Well No.

Office Address Stafford, Kansas

Character of Well (Completed as Oil, Gas or Dry Hole)

Date Well completed 19

Application for plugging filed 19

Application for plugging approved 19

Plugging commenced 5/5/80 19

Plugging completed 5/12/80 19

Reason for abandonment of well or producing formation depleted.


If a producing well is abandoned, date of last production 19

Was permission obtained from the Conservation Division or its agents before plugging was commenced? ~~Schmidt~~ yes

Name of Conservation Agent who supervised plugging of this well Schmidt

Producing formation Depth to top Bottom Total Depth of Well 4175

Show depth and thickness of all water, oil and gas formations.

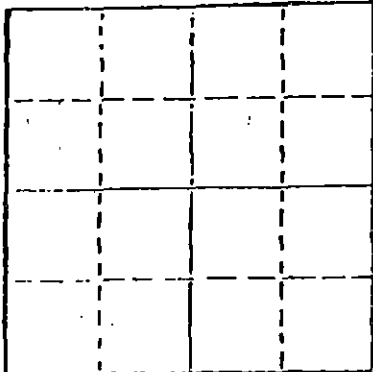

Locate well correctly on above Section Plat

OIL, GAS OR WATER RECORDS

CASING RECORD

FORMATION	CONTENT	FROM	TO	SIZE	PUT IN	PULLED OUT
				8-5/8	331	none
				4 1/2"	4138	3521'

Describe in detail the manner in which the well was plugged, indicating where the mud fluid was placed and the method or methods used in introducing it into the hold. If cement or other plugs were used, state the character of same and depth placed, from feet to feet for each plug set.

Squeezed 4 1/2" casing with 35 sacks cement. Pumped plug to 4000', shot pipe at 3655', 3500', pulled 108 joints. Squeezed hole with 3 sacks hulls, 25 sacks gel, 3 sacks hulls. Released plug and displaced with 140 sacks 50-50 pozmix, 4% gel and 3% cc.

PLUGGING COMPLETE.

Stamp: STATE CORPORATION COMMISSION RECEIVED MAY 1 1980 WICHITA, KANSAS 5-1380

(If additional description is necessary, use BACK of this sheet)

Name of Plugging Contractor KELSO CASING PULLING CHASE, KANSAS

STATE OF KANSAS COUNTY OF RICE, ss. R. DARRELL KELSO (employee of owner) or (owner or operator)

of the above-described well, being first duly sworn on oath, says: That I have knowledge of the facts, statements, and matters herein contained and the log of the above-described well as filed and that the same are true and correct. So help me God.

(Signature) R. Darrell Kelso CHASE, KANSAS

(Address) CHASE, KANSAS

SUBSCRIBED AND SWORN TO before me this 12th day of May, 19 80

Margaret Melcher Notary Public.

My commission expires

