

15.145-21046-0000


STATE OF KANSAS  
STATE CORPORATION COMMISSION

WELL PLUGGING RECORD

Give All Information Completely  
Make Required Affidavit  
Mail or Deliver Report to  
Conservation Division  
State Corporation Comm.  
245 North Water  
Wichita, KS 67202

Barton County, Sec. 3 Twp. 22 Rge. 16 E/W  
Location as "NE/CNW $\frac{1}{4}$ SW $\frac{1}{4}$ " or footage from lines  
E/2 W/2 NW/4

Lease Owner L. D. Davis/L. D. Drilling, Inc.  
Lease Name BALDWIN Well No. 1  
Office Address Rt #1, Box 183B, Great Bend, KS 67530  
Character of Well (Completed as Oil, Gas or Dry Hole) \_\_\_\_\_

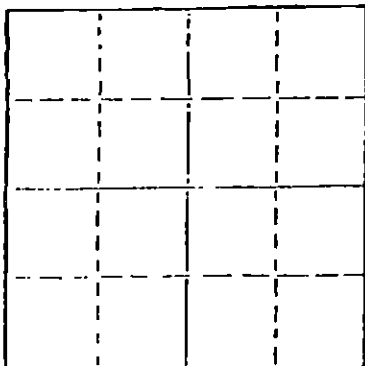

Locate well correctly on above  
Section Plat

Dry Hole  
Date Well completed June 30 1983  
Application for plugging filed June 30 1983  
Application for plugging approved June 30 1983  
Plugging commenced 1:00 June 30, 1983  
Plugging completed 2:00 June 30, 1983  
Reason for abandonment of well or producing formation \_\_\_\_\_

Dry Hole  
If a producing well is abandoned, date of last production \_\_\_\_\_ 19\_\_\_\_

Was permission obtained from the Conservation Division or its agents before plugging was commenced? yes

Name of Conservation Agent who supervised plugging of this well Richard Lacey  
Producing formation \_\_\_\_\_ Depth to top \_\_\_\_\_ Bottom \_\_\_\_\_ Total Depth of Well 3890  
Show depth and thickness of all water, oil and gas formations.

OIL, GAS OR WATER RECORDS

CASING RECORD

FORMATION	CONTENT	FROM	TO	SIZE	PUT IN	PULLED OUT

Describe in detail the manner in which the well was plugged, indicating where the mud fluid was placed and the method or methods used in introducing it into the hold. If cement or other plugs were used, state the character of same and depth placed, from \_\_\_\_\_ feet to \_\_\_\_\_ feet for each plug set.

40 SX @ 1020'  
40 SX @ 510'  
10 SX @ 40'  
10 SX in Rathole

(If additional description is necessary, use BACK of this sheet)

Name of Plugging Contractor L. D. Drilling, Inc.


STATE OF KANSAS COUNTY OF BARTON, ss.  
DON POPP (employee of owner) or ~~(owner/cooperator)~~

of the above-described well, being first duly sworn on oath, says: That I have knowledge of the facts, statements, and matters herein contained and the log of the above-described well as filed and that the same are true and correct. So help me God.

(Signature)

Don Popp, Hoisington, KS 67544  
(Address)

SUBSCRIBED AND SWORN TO before me this 1st day of July, 19 83

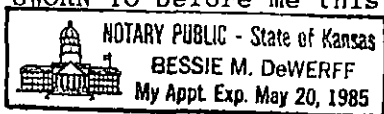

Bessie M. DeWerff  
Notary Public.

My commission expires 5-20-85

4792

RECEIVED  
STATE CORPORATION COMMISSION

JUL 22 1983

CONSERVATION DIVISION  
Wichita, Kansas