


Give All Information Completely
Make Required Affidavit
Mail or Deliver Report to:
Conservation Division
State Corporation Commission
212 North Market, Insurance Bldg.
Wichita, Kansas

RECEIVED
JUL 18 1960

WELL PLUGGING RECORD

Pawnee County, Sec. 3 Twp. 22 Rge. 16 (E) W (W)

NORTH

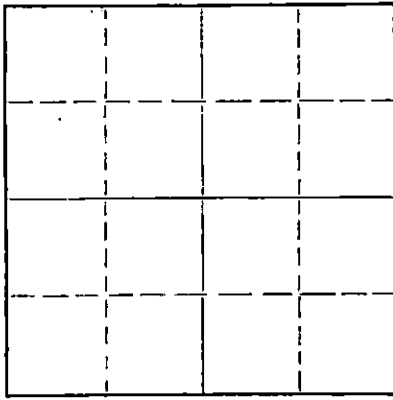

Locate well correctly on above
Section Plat

Location as "NE/CNW/SW" or footage from lines NE NE NW
Lease Owner Musgrove Drilling Company
Lease Name Baldwin Well No. A-1
Office Address Wichita, Kansas
Character of Well (completed as Oil, Gas or Dry Hole) Oil well - now dry
Date well completed March 14 1953
Application for plugging filed June 6, 1960
Application for plugging approved June 9, 1960
Plugging commenced 7-8-60 19
Plugging completed 7-12-60 19
Reason for abandonment of well or producing formation Depleted.

If a producing well is abandoned, date of last production June 1960
Was permission obtained from the Conservation Division or its agents before plugging was commenced? yes

Name of Conservation Agent who supervised plugging of this well Frank Broadfoot.
Producing formation _____ Depth to top _____ Bottom _____ Total Depth of Well 3879 Feet
Show depth and thickness of all water, oil and gas formations.

OIL, GAS OR WATER RECORDS

CASING RECORD

FORMATION	CONTENT	FROM	TO	SIZE	PUT IN	PULLED OUT
				8-5/8"	1013'	None
				5-1/2"	3862'	2946'

Describe in detail the manner in which the well was plugged, indicating where the mud fluid was placed and the method or methods used in introducing it into the hole. If cement or other plugs were used, state the character of same and depth placed, from _____ feet to _____ feet for each plug set.

Checked hole to 3879' and found it clear.
Sanded hole to 3850' and dumped 5 sacks of cement with dump bailer. Pulled 5 1/2" casing.
Mudded hole to 300', set rock bridge to 290' and ran 30 sacks of cement. Mudded hole to 35', set rock bridge to 25' and ran 10 sacks of cement to base of cellar.

RECEIVED
STATE CORPORATION COMMISSION

JUL 21 1960

CONSERVATION DIVISION
Wichita, Kansas

7-21-60

(If additional description is necessary, use BACK of this sheet)
Name of Plugging Contractor KNIGHT CASING PULLING COMPANY
Address CHASE, KANSAS

STATE OF Kansas COUNTY OF Rice, ss.
Noel J. Knight (employee of owner) or (owner or operator) of the above-described well, being first duly sworn on oath, says: That I have knowledge of the facts, statements, and matters herein contained and the log of the above-described well as filed and that the same are true and correct. So help me God.

(Signature) Noel J. Knight
Chase, Kansas
(Address)

SUBSCRIBED AND SWORN TO before me this 15th day of July, 1960

My commission expires 5-20-60 Milton J. Volin Notary Public.

CONTRACTOR'S WELL LOG

COMPANY:
CONTRACTOR:
FARM:
LOCATION:

Musgrove Petroleum Corporation
Musgrove Petroleum Corporation
Baldwin #1
NE NE NW Section 3-22-16
Pawnee County, Kansas

COMMENCED:
COMPLETED:

February 24, 1953
March 14, 1953

0	50	Sand
50	75	Sandy clay
75	135	Sand
135	340	Shale
340	660	Shale, sand red bed and shells
660	981	Shale and shells
981	982	Chalk
982	985	Anhydrite
985	1115	Shale, sand, shells and anhydrite
1115	1820	Shale and shells
1820	2170	Lime and shale
2170	2500	Lime
2500	2642	Shale, lime and shells
2642	2760	Shale and shells
2760	3558	Shale and lime
3558	3642	Lime
3642	3690	Lime and shale
3690	3780	Lime
3780	3842	Conglomerate
3842	3860	Lime
3860	3878	Arbuckle
	3878	Rotary Total Depth

Set 8 5/8" at 985' with 425 sacks of cement.

Set 5 1/2" casing at 3862' with 150 sacks of cement.

RECEIVED
STATE CORPORATION COMMISSION

JUN 8 1960

STATE OF KANSAS)
COUNTY OF SEDGWICK) SS

CONSERVATION DIVISION
Wichita, Kansas

I, GORDON L. KOELLING, do hereby certify that the above and foregoing is a true and correct copy of the log of the Baldwin #1 Section 3-22-16 Pawnee County, Kansas, as reflected by the files of the Musgrove Petroleum Corporation.

MUSGROVE PETROLEUM CORPORATION
By Gordon L. Koelling
Secretary-Treasurer

Subscribed and sworn to before me a Notary Public in and for Sedgwick County Kansas, this 20th day of March, 1953.

Mary L. Sumner
Notary Public

My Commission Expires: November 14, 1956.