


WELL PLUGGING RECORD

Give All Information Completely
Make Required Affidavit
Mail or Deliver Report to:
Conservation Division
State Corporation Commission
212 North Market, Insurance Bldg.
Wichita, Kansas

Pawnee County, Sec. 3 Twp. 22 Rge. 16 (E) W (W)

Location as "NE/CNW/SW" or footage from lines SW NE NW
Lease Owner Musgrove Drilling Co.
Lease Name Baldwin Well No. A#2
Office Address Wichita, Kansas
Character of Well (completed as Oil, Gas or Dry Hole) Oil - now depleted
Date well completed July 31 19 53
Application for plugging filed June 6 19 60
Application for plugging approved June 9 19 60
Plugging commenced 7-5-60 19
Plugging completed 7-7-60 19
Reason for abandonment of well or producing formation Depleted.

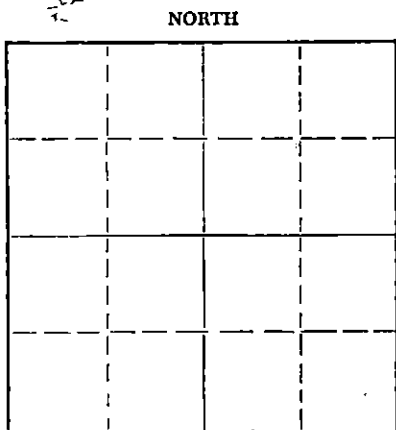

Locate well correctly on above Section Plat

If a producing well is abandoned, date of last production June 19 60
Was permission obtained from the Conservation Division or its agents before plugging was commenced? yes

Name of Conservation Agent who supervised plugging of this well Frank Broadfoot
Producing formation _____ Depth to top _____ Bottom _____ Total Depth of Well 3870 Feet
Show depth and thickness of all water, oil and gas formations.

OIL, GAS OR WATER RECORDS

CASING RECORD

FORMATION	CONTENT	FROM	TO	SIZE	PUT IN	PULLED OUT
				8-5/8"	998	None
				5-1/2"	3865	2891'

Describe in detail the manner in which the well was plugged, indicating where the mud fluid was placed and the method or methods used in introducing it into the hole. If cement or other plugs were used, state the character of same and depth placed, from _____ feet to _____ feet for each plug set.

Checked hole to 3870' and found it clear.
Sanded hole to 3850' and dumped 5 sacks of cement with dump bailer. Pulled casing mudded hole to 300', set 10' rock bridge to 290' and ran 30 sacks of cement. Mudded hole to 35', set 10' rock bridge to 25' and ran 10 sacks of cement to base of cellar.

PLUGGING COMPLETED.

RECEIVED
STATE CORPORATION COMMISSION

JUL 21 1960

CONSERVATION DIVISION
Wichita, Kansas

(If additional description is necessary, use BACK of this sheet)
Name of Plugging Contractor KNIGHT CASING PULLING COMPANY
Address CHASE, KANSAS

STATE OF Kansas COUNTY OF Rice, ss.
Noel J. Knight (employee of owner) or (owner or operator) of the above-described well, being first duly sworn on oath, says: That I have knowledge of the facts, statements, and matters herein contained and the log of the above-described well as filed and that the same are true and correct. So help me God.

(Signature) Noel J. Knight
Chase, Kansas

SUBSCRIBED AND SWORN TO before me this 11th day of July, 19 60

My commission expires May 20, 1964 Milton J. Colvin Notary Public.



