


WELL PLUGGING RECORD

Give All Information Completely
Make Required Affidavit
Mail or Deliver Report to:
Conservation Division
State Corporation Commission
212 North Market, Insurance Bldg.
Wichita, Kansas

NORTH

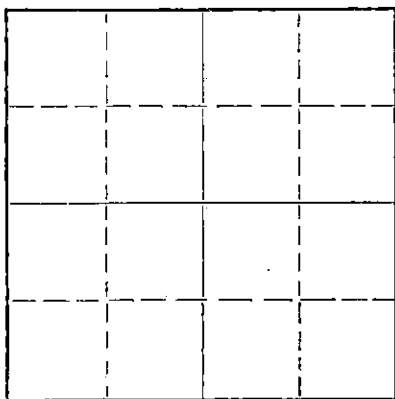

Locate well correctly on above
Section Plat

Pawnee County. Sec. 3 Twp. 22 Rge. 16 (E) W(W)
Location as "NE/CNW/SW" or footage from lines 1650 NL, 350' WL
Lease Owner Musgrove Petroleum Co.
Lease Name Baldwin "A" #5 Well No.
Office Address Wichita, Kansas
Character of Well (completed as Oil, Gas or Dry Hole)
Date well completed 19
Application for plugging filed 19
Application for plugging approved 19
Plugging commenced 2-6-59 19
Plugging completed 2-11-59 19
Reason for abandonment of well or producing formation

If a producing well is abandoned, date of last production 19
Was permission obtained from the Conservation Division or its agents before plugging was commenced? yes

Name of Conservation Agent who supervised plugging of this well Frank Broadfoot
Producing formation Depth to top Bottom Total Depth of Well 3853 Feet
Show depth and thickness of all water, oil and gas formations.

OIL, GAS OR WATER RECORDS

CASING RECORD

FORMATION	CONTENT	FROM	TO	SIZE	PUT IN	PULLED OUT
				8-5/8"	983'	none
				5-1/2"	3850'	2511'

Describe in detail the manner in which the well was plugged, indicating where the mud fluid was placed and the method or methods used in introducing it into the hole. If cement or other plugs were used, state the character of same and depth placed, from feet to feet for each plug set.

Checked the hole to 3853' and found it open.
Filled w/sand to 3840' and dumped 5 sacks of cement with bailer. Pulled 5 1/2" casing, cleared hole, hooked up circulating and pumped in 20 sacks of gel mud and 80 sacks of cement. Checked top of cement to 30' and ran 5 sacks of cement to base of cellar.

PLUGGING COMPLETED

RECEIVED
STATE CORPORATION COMMISSION
FEB 20 1959
CONSERVATION DIVISION
Wichita

(If additional description is necessary, use BACK of this sheet)
Name of Plugging Contractor West Supply Co., Inc. 2-20-59
Address Chase, Kansas

STATE OF KANSAS, COUNTY OF RICE, SS.
I, Noel J. Knight (employee of owner) or (owner or operator) of the above-described well, being first duly sworn on oath, says: That I have knowledge of the facts, statements, and matters herein contained and the log of the above-described well as filed and that the same are true and correct. So help me God.

(Signature) *Noel J. Knight*
Chase, Kansas (Address)

SUBSCRIBED AND SWORN TO before me this 17th day of February, 1959

9-27-62 *Thomas V. Boyer* Notary Public.

My commission expires

PLUGGING
FILE SEC. 3 T. 22 R. 16 W
BOOK PAGE 14 LINE 8

CONTRACTOR'S WELL LOG

COMPANY:	Musgrove Petroleum Corporation
CONTRACTOR:	Musgrove Petroleum Corporation
FARM:	Baldwin #5
LOCATION:	1650' from North Line & 350' from West Line of Sec. 3-22S-16W, Pawnee County, Kansas.
COMMENCED:	January 27, 1954
COMPLETED:	February 5, 1954

0	275	Sand and shells
275	775	Sand and shale
775	979	Shale, sand, red bed
979	1015	Anhydrite
1015	1500	Shale & red bed
1500	1745	Shale & shell
1745	1905	Shale & lime
1905	2090	Lime
2090	3528	Shale & lime
3528	3853	Lime
	3853	Rotary Total Depth

Set 8-5/8" surface casing at 984' with 425 sacks cement

Set 5-1/2" casing at 3851' with 200 sacks cement

STATE OF KANSAS)
 COUNTY OF SEDGWICK) SS

I, GORDON L. KOELLING, do hereby certify that the above and foregoing is a true and correct copy of the log of the BALDWIN #5, 1650' from north line and 350' from west line of Section 3-22S-16W, Pawnee County, Kansas, as reflected by the files of the Musgrove Petroleum Corporation.

MUSGROVE PETROLEUM CORPORATION

BY *Gordon L. Koelling*
 Secretary-Treasurer

Subscribed and sworn to before me, a Notary Public, in and for Sedgwick County, Kansas, this 8th day of February, 1954.

William A. Stinson
 Notary Public

My commission expires September 24, 1956.

RECEIVED
 STATE CORPORATION COMMISSION

JAN 31 1959

CONSERVATION DIVISION
 Wichita, Kansas

PLUGGING
 FILE SEC 3 T22 R16W
 BOOK PAGE 14 LINE 8