


WELL PLUGGING RECORD

Give All Information Completely
Make Required Affidavit
Mail or Deliver Report to:
Conservation Division
State Corporation Commission
800 Bittling Building
Wichita, Kansas

Pawnee County. Sec. 3 Twp. 22S Rge. 16 E W (W)
Location as "NE/CNW $\frac{1}{4}$ SW $\frac{1}{4}$ " or footage from lines NW NW SW
Lease Owner Vickers Explorations Ltd.
Lease Name Buster Well No. 1
Office Address Box 2240 Wichita, Kansas
Character of Well (completed as Oil, Gas or Dry Hole) Dry Hole
Date well completed June 16 19.53
Application for plugging filed June 16 19.53
Application for plugging approved June 16 19.53
Plugging commenced June 16 19.53
Plugging completed June 16 19.53
Reason for abandonment of well or producing formation Dry

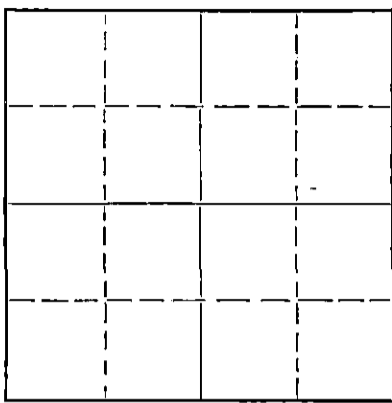

Locate well correctly on above Section Plat

If a producing well is abandoned, date of last production 19.
Was permission obtained from the Conservation Division or its agents before plugging was commenced? Yes

Name of Conservation Agent who supervised plugging of this well Mr. M. A. Rives Pratt, Kansas
Producing formation Depth to top Bottom Total Depth of Well 3967 Feet
Show depth and thickness of all water, oil and gas formations.

OIL, GAS OR WATER RECORDS

CASING RECORD

Formation	Content	From	To	Size	Put In	Pulled Out
				8 5/8	986	None

Describe in detail the manner in which the well was plugged, indicating where the mud fluid was placed and the method or methods used in introducing it into the hole. If cement or other plugs were used, state the character of same and depth placed, from feet to feet for each plug set.

Filled hole with mud to 270'. Set plug, and hulls at 270'. Dumped 20 sx cement.
Filled hole to 40' with mud. Set plug and dumped 10 sx cement.

6-30-53

(If additional description is necessary, use BACK of this sheet)

Name of Plugging Contractor Jayhawk Drilling Co., Inc.
Address Box 2240 Wichita, Kansas


STATE OF Kansas, COUNTY OF Sedgwick, ss.
John M. Little (employee of owner) or (owner or operator) of the above-described well,

being first duly sworn on oath, says: That I have knowledge of the facts, statements, and matters herein contained and the log of the above-described well as filed and that the same are true and correct. So help me God.

(Signature) *John M. Little*
Box 2240 Wichita, Kansas (Address)

SUBSCRIBED AND SWORN TO before me this 23 day of June, 19.53.
Allen P. Denton Notary Public.

My commission expires August 13, 1953

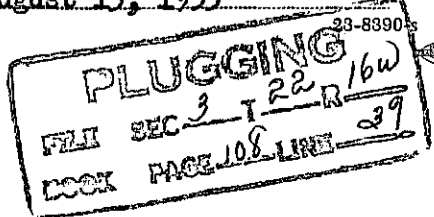

VICKERS EXPLORATIONS., LTD.

Buster Well #1
NW NW SW Sec. 3-22S-16W
Pawnee County, Kansas

Casing Record:
8 5/8" @ 986' w/ 450sx

Commenced: June 3, 1953
Completed: June 16, 1953

Elevation: 1997 R. B.

D. & A.

LOG

Sand	0-90	Shale, Black	3407-3412
Shale, Shells & Sand	90-160	Lime & Shale	3412-3425
Shale & Shells	160-340	Lime	3425-3444
Sand	340-550	Shale & Sand	3444-3516
Red Bed Shale, Shells	550-750	Lime	3516-3521
Shale	750-983	Shale	3521-3526
Anhydrite	983-1021	Lime	3526-3777
Shale & Shells	1021-1477	Shale, Lime & Dolomite	3777-3839
Shale	1477-1855	Chert	3839-3872
Lime & Shale	1855-2005	Shale & Sand	3872-3924
Lime & Shale Broken	2005-2155	Chert, Lime & Shale	3924-3937
Lime	2155-2250	Dolomite	3937-3967 T D
Lime & Shale	2250-2540		
Shale	2540-2690		
Lime & Shale	2690-3235		
Lime	3235-3407		

DST 3941-3952 Weak blow for 10
minutes open 1/2 hr.
Shut in 20 minutes Recovered 15#
mud. BHP 1210#

Markers

	Sample	Schlumberger
Heebner	3407	3408
Toronto	3425	3426
Douglas	3444	3444
Brown lime	3516	3517
Lansing	3526	3527
Base Kan. City	3777	3778
Viola	3839	3840
Simpson Shale	3872	3871
Shaley Arbuckle	3924	3924
Solid Arbuckle	3937	3937

I hereby certify that this Log is true and correct to the best of my knowledge and belief.

THE VICKERS EXPLORATIONS., LTD..

BY H. C. Davis

Subscribed and sworn to before me this 22 day of June, 1953.

My Commission expires August 13, 1953.

Allen J. Denton
Notary Public

RECORDED
STATE OF KANSAS

JUN 30 1953

CONSERVATION DIVISION
Wichita, Kansas

