


MAR 6 1969  
CONSERVATION DIVISION  
Wichita, Kansas

Form CP-4

STATE OF KANSAS  
STATE CORPORATION COMMISSION

Give All Information Completely  
Make Required Affidavit  
Mail or Deliver Report to:  
Conservation Division  
State Corporation Commission  
211 No. Broadway  
Wichita, Kansas

WELL PLUGGING RECORD

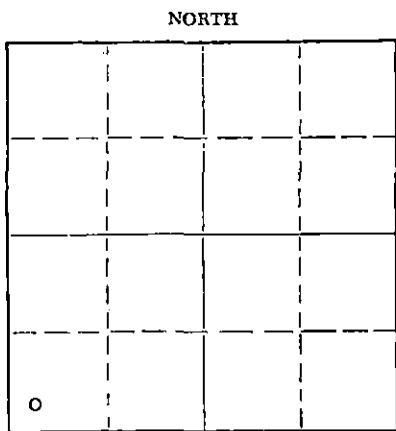

Locate well correctly on above  
Section Plat

Pawnee County. Sec. 35 Twp. 22 Rge. (E) 17 (W)  
Location as "NE/CNW/SW" or footage from lines. SW SW SW  
Lease Owner Colorado Oil Company  
Lease Name Boyd Well No. 1  
Office Address 915 Union National Bldg., Wichita, Kansas  
Character of Well (completed as Oil, Gas or Dry Hole) Oil  
Date well completed June 27 19 55  
Application for plugging filed January 24 19 69  
Application for plugging approved January 27 19 69  
Plugging commenced February 3 19 69  
Plugging completed February 25 19 69  
Reason for abandonment of well or producing formation Depleted.

If a producing well is abandoned, date of last production April 19 64  
Was permission obtained from the Conservation Division or its agents before plugging was commenced? Yes

Name of Conservation Agent who supervised plugging of this well Leo Massey  
Producing formation Conglomerate Depth to top 4130 Bottom Total Depth of Well 4270 Feet  
Show depth and thickness of all water, oil and gas formations.

OIL, GAS OR WATER RECORDS

CASING RECORD

FORMATION	CONTENT	FROM	TO	SIZE	PUT IN	PULLED OUT
				8-5/8"	242'	None
				5-1/2"	4269'	3413'

Describe in detail the manner in which the well was plugged, indicating where the mud fluid was placed and the method or methods used in introducing it into the hole. If cement or other plugs were used, state the character of same and depth placed, from feet to feet for each plug set.

Pumped 100 bbls water to kill gas, ran sand from 4162 to 4100'.  
Mixed & dumped 5 sacks cement. Loaded hole, shot pipe @ 3513',  
3390', spotted 50 bbls oil, worked pipe loose and pulled 107 jnts.  
Pumped 20 sacks mud, 5 sacks hulls & 100 sacks cement.

PLUGGING COMPLETE.

(If additional description is necessary, use BACK of this sheet)  
Name of Plugging Contractor Knight Casing Pulling Co., Inc.  
Address P. O. Box 405, Chase, Kansas

STATE OF Kansas, COUNTY OF Sedgwick, ss.  
Bill K. Henrichs (employee of owner) or (owner or operator) of the above-described well, being first duly sworn on oath, says: That I have knowledge of the facts, statements, and matters herein contained and the log of the above-described well as filed and that the same are true and correct. So help me God.

(Signature) Bill K. Henrichs  
915 Union National Bldg., Wichita, Kansas  
(Address)

SUBSCRIBED AND SWORN to before me this 5th day of March 19 69

My commission expires

February 19, 1973

Betty J. McElwain  
Betty J. McElwain Notary Public.

HONAKER DRILG., INC.  
2008 LAKIN  
GRILAT BEND, KANSAS

RECEIVED  
STATE CORPORATION COMMISSION  
JAN 27 1969  
CONSERVATION DIVISION  
Wichita, Kansas

No. 1 Boyd  
Loc: SW SW SW  
Sec: 35-22-17  
Pawnee County, Kansas  
Contractor: Honaker Drilg., Inc.  
Company: Honaker Drilg., Inc. &  
The Derby Oil Company

Comm: 9-21-54  
Comp: 10-4-54  
Total Depth: 4269'  
Elevation: 2074 D.F.  
Casing: 8-5/8" @ 242'.  
5-1/2" @ 4269'.

0	60	Sand & Gravel.	
60	190	Clay	
190	400	Blue Shale	8-5/8" casing cemented at
400	900	Red Bed	242' with 200 sacks cement
900	1150	Red Bed & Shale	and 4 sacks calcium chloride.
1150	1179	Anhydrite	
1179	1600	Shale & Shells	
1600	1670	Salt	
1670	1985	Shale & Shells	
1985	2250	Lime & Shale	
2250	2270	Lime, Shale & Chert	
2270	3939	Lime & Shale	
3939	4120	Lime	
4120	4147	Lime & Chert	
4147	4183	Lime	
4183	4269	Lime & Chert	5-1/2" casing cemented at
4269		Total Rotary Depth	4269' with 175 sacks cement.

I certify that this is the true and correct copy of the  
above log, to the best of my knowledge.

*A. J. Forbes*

Subscribed and sworn to before me this 8 day of October  
1954.

*Raymond D. Fisher*  
Notary Public

My Commission Expires 6-25-55