

10


STATE OF KANSAS
STATE CORPORATION COMMISSION

Give All Information Completely
Make Required Affidavit
Mail or Deliver Report to:
Conservation Division
State Corporation Commission
211 No. Broadway
Wichita, Kansas

WELL PLUGGING RECORD

Pawnee County, Sec. 35 Twp. 22 Rge. (E) 17 (W)
Location as "NE/CNW%SW%" or footage from lines SW SW SE
Lease Owner Colorado Oil and Gas Corporation
Lease Name JENNINGS Well No. 1
Office Address Wichita, Kansas
Character of Well (completed as Oil, Gas or Dry Hole) Oil
Date well completed August 30 19 55
Application for plugging filed August 9 19 61
Application for plugging approved August 11 19 61
Plugging commenced August 21 19 61
Plugging completed August 26 19 61
Reason for abandonment of well or producing formation Depleted

NORTH

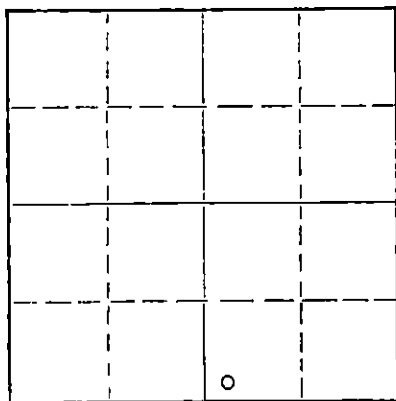

Locate well correctly on above
Section Plat

If a producing well is abandoned, date of last production December 31 19 61
Was permission obtained from the Conservation Division or its agents before plugging was commenced? Yes

Name of Conservation Agent who supervised plugging of this well Frank Broadfoot
Producing formation Conglomerate Chert Depth to top 4159 Bottom Total Depth of Well 4250 Feet
Show depth and thickness of all water, oil and gas formations. PBTD 4224

OIL, GAS OR WATER RECORDS

CASING RECORD

FORMATION	CONTENT	FROM	TO	SIZE	PUT IN	PULLED OUT
				8-5/8"	1111'	None
				5-1/2"	4229'	2617'

Describe in detail the manner in which the well was plugged, indicating where the mud fluid was placed and the method or methods used in introducing it into the hole. If cement or other plugs were used, state the character of same and depth placed, from feet to feet for each plug set.

Checked hole to 4224'. Sanded to 4170' and dumped 5 sacks of cement at 4170' with dump bailer. Pulled 5-1/2" casing. Checked fluid to 300', mudded to 250', set 10' rock bridge to 240' and ran 20 sacks of cement from 240' to 180'. Mudded from 180' to 40', set 10' rock bridge to 30' and ran 10 sacks of cement to base of cellar.

PLUGGING COMPLETE.

RECEIVED
STATE CORPORATION COMMISSION

SEP 8 1961

CONSERVATION DIVISION
Wichita, Kansas

9-8-61

(If additional description is necessary, use BACK of this sheet)

Name of Plugging Contractor Knight Casing Pulling Company
Address Chase, Kansas

STATE OF Kansas, COUNTY OF Sedgwick, ss.

Bill K. Henrichs (employee of owner) or (owner) of the above-described well, being first duly sworn on oath, says: That I have knowledge of the facts, statements, and matters herein contained and the log of the above-described well as filed and that the same are true and correct. So help me God.

(Signature) *Bill K. Henrichs*

Bill K. Henrichs
Box 1030, Wichita, Kansas
(Address)

SUBSCRIBED AND SWORN to before me this 7th day of September, 19 61

Helen L. Martin

My commission expires August 19, 1963

Helen L. Martin

Notary Public.



DRILLERS LOG

Frank Jennings #1
 Loc: SW SW SE
 Sec: 35-22-17
 Pawnee County, Kansas
 Company: Colorado Oil & Gas Corporation
 Contractor: Honaker Drlg., Inc.

Comm: 8-14-55
 Comp: 8-30-55
 Rotary Total Depth: 4250
 Casing: 8-5/8" at 1111
 5-1/2" at 4229.94
 Elevation: 2077 K.B.

0	65	Clay & Sand	
65	120	Sand & Clay	
120	385	Shale	8-5/8" Casing cemented
385	560	Red Bed	at 1111' with 700 sacks
560	635	Sand	cement.
635	1102	Shale & Red Bed	
1102	1125	Anhydrite	
1125	1800	Shale & Shells	
1800	2000	Shale & Lime Streaks	
2000	4171	Lime & Shale	
4171	4181	Chert & Shale	5-1/2" Casing cemented at
4181	4235	Conglomerate	4229.94 with 125 sacks
4235	4250	Viola Lime	cmt.
4250		Total Rotary Depth	

GEOLOGICAL FORMATIONS:

Heebner: 3614
 Lansing: 3730
 Congl. Shale: 4136
 Congl. Chert: 4159
 Viola: 4230
 RTD: 4250
 PRTD: 4224

RECEIVED
 STATE CORPORATION COMMISSION

AUG 10 1961

CONSERVATION DIVISION
 Wichita, Kansas